

NEWTON

T

J5

WATER WELL DRILLERS LOG

4-28-62

Date: 4-28, 1962, Driller: Roy Wilkerson County Newton  
(Name)

(1) Owner of Land: Robert Halingath  
(Name)

Lake, Miss  
(Address)

(2) Location: 1/4, 1/4, Sec. 5 T<sup>14</sup> R<sup>10E</sup>  
3 miles N.E. of Lake  
(distance) (direction) (Nearest Town)

(3) Topography:  
(Hilly) (Flat) (Level)

(4) Purpose of Well: Domestic  
(Domestic Irrigation  
Municipal, Industrial, Other)

Description & Color of Materials Sand, Clay, Red Clay, Shell, etc.	Thick- ness Feet	Depth Feet
After few in. top		
Soil - then Red clay	20	
Red sand	10	
White sand	20	
Water sand	40	

Information upon completion of well:

(1) Diameter 2 inches.

(2) Total Depth 90 feet.

(3) Water Level 40 feet below top of ground.

(4) Cased to 90 ft, Size 2"


(5) Screen: Size 2", Length 6'

(6) Were any formations sealed against pollution?  
yes, no.

If YES depth of formation

Why

Drillers Remarks:

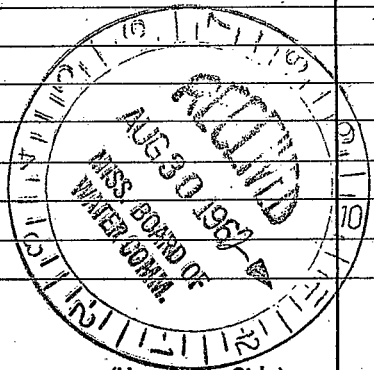

(Use Back Side)

Well No.

1870

1871

1872

1873

1874

1875

1876