

3 NEWTON

J 7

WATER WELL DRILLERS LOG

5-17-63

Date: 5-17, 1963, Driller: W. L. [Signature] county Newton

(Name)

(1) Owner of Land: J. H. Moyers (Name)

Lake Moss (Address)

(2) Location: SW 1/4 NW 1/4, Sec. 8 T. 1 R. 10

miles of (distance) (direction) (Nearest Town)

(3) Topography: (Hilly) (Flat) (Level)

(4) Purpose of Well: (Domestic Irrigation) (Municipal, Industrial, Other)

Information upon completion of well:

(1) Diameter: 2 inches.

(2) Total Depth: 111 feet.

(3) Water Level: 50 feet below top of ground.

(4) Cased to: 111, Size: 2 1/2

(5) Screen: Size: 8 mesh, Length: 6'


(6) Were any formations sealed against pollution? yes, no [checked]

If YES depth of formation

Why

Drillers Remarks:

Description & Color of Materials Sand, Clay, Red Clay, Shell, etc.	Thick- ness Feet	Depth Feet
Clay	11	0-11
Sandy	11	11-22
Blue	31	22-53
Sand	58	53

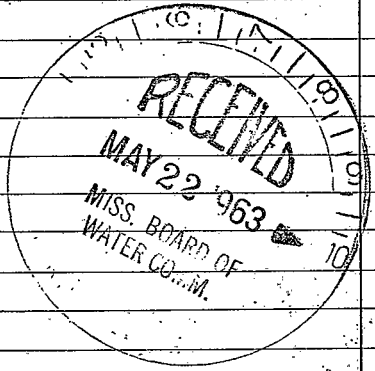

(Use Back Side)

Well No. 25

1. The first part of the document  
describes the general situation  
of the country and the  
state of the economy.  
It also mentions the  
main problems that  
the government is  
facing at the moment.  
The second part of the  
document discusses the  
measures that the  
government has taken  
to solve these problems.  
It also mentions the  
results of these  
measures and the  
prospects for the  
future.

2. The second part of the document  
discusses the measures that the  
government has taken to solve these  
problems. It also mentions the  
results of these measures and the  
prospects for the future.