

J12

7-29-64

WATER WELL DRILLERS LOG

Date: 7-29, 1964, Driller: W. D. Welch County Newton  
(Name)

- (1) Owner of Land: B. B. Gibbs (Name)  
Lake Miss (Address)
- (2) Location: SW 1/4, NW 1/4, Sec. 8 T6 R10,  
3 miles N of Lake (distance, direction, Nearest Town)
- (3) Topography: (Hilly) (Flat) (Level)
- (4) Purpose of Well: Domestic (Domestic Irrigation, Municipal, Industrial, Other)

Description & Color of Materials Sand, Clay, Red Clay, Shell, etc.	Thick- ness Feet	Depth Feet
Clay	10	2-10
Blue	54	10-64
Blue + sandy	21	64-85
Sand	21	85-106


Information upon completion of well:

- (1) Diameter 2 inches.
- (2) Total Depth 106 feet.
- (3) Water Level 40 feet below top of ground.
- (4) Cased to 106, Size 2"
- (5) Screen: Size 8 Slot, Length 6'
- (6) Were any formations sealed against pollution?  
yes,  no.

If YES depth of formation \_\_\_\_\_

Why \_\_\_\_\_

Drillers Remarks: \_\_\_\_\_

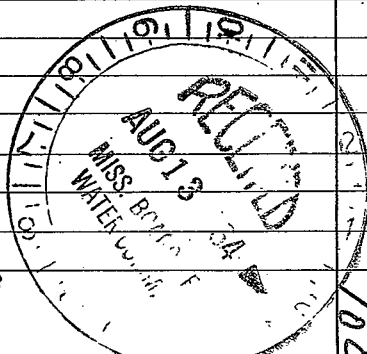

9

(Use Back Side)

106

Well No.

