

3 NEWTON
J14
9-7-65

T

WATER WELL DRILLERS LOG

Date: 9-7, 1965, Driller: J. L. Shalch County Newton
(Name)

(1) Owner of Land: L. Williams
(Name)
Lawrence Miss
(Address)

(2) Location: NE 1/4, NE 1/4, Sec. 10 T. 6 R. 10 E.
3 miles NW, of Lawrence
(distance) (direction) (Nearest Town)

(3) Topography: ✓
(Hilly) (Flat) (Level)

(4) Purpose of Well: Domestic
(Domestic Irrigation
Municipal, Industrial, Other)

Description & Color of Materials Sand, Clay, Red Clay, Shell, etc.	Thick- ness Feet	Depth Feet
<u>Red Clay</u>	<u>26</u>	<u>0-26</u>
<u>Blue</u>	<u>48</u>	<u>26-74</u>
<u>Grey</u>	<u>64</u>	<u>74-138</u>
<u>Brown</u>	<u>95</u>	<u>138</u>
<u>Sand</u>	<u>71</u>	<u>233</u>
		<u>304</u>

Information upon completion of well:

(1) Diameter 2 inches.

(2) Total Depth 304 feet.

(3) Water Level 50 feet below top of ground.


(4) Cased to 304, Size 2"

(5) Screen: Size 60 Mesh Length 10'

(6) Were any formations sealed against pollution?
no

If YES depth of formation _____
Why _____

Drillers Remarks: _____

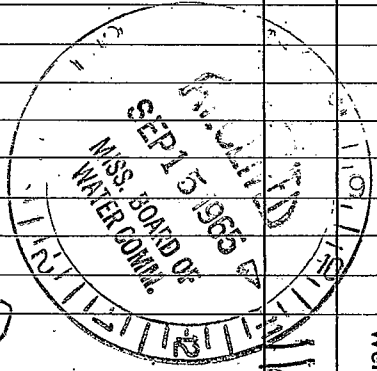

10

(Use Back Side)

Well No.

