

6

7

NEWTON

J 15 MISSISSIPPI BOARD OF WATER COMMISSIONERS

3-31-66

WATER WELL DRILLERS LOG

Date: 3-31, 1966, Driller LEACH County Newton


(1) Owner of Land: J.A. Kelley
(2) Location: 1/4, 1/4, Sec. 5 T6R10, 5 miles n-east of Lake
(3) Topography: (Hilly)
(4) Purpose of Well: (Domestic Irrigation)

Table with 3 columns: Description & Color of Materials, Thickness Feet, Depth Feet. Contains handwritten entries: Red clay, Yellow, Sand with thicknesses 10, 20, 75 and depths 10, 30, 105.

Information upon completion of well:

(1) Diameter 2 inches.
(2) Total Depth 105 feet.
(3) Water Level 10 feet below top of ground.
(4) Cased to 100, Size 2
(5) Screen: Size 2, Length 5'
(6) Were any formations sealed against pollution? yes, no.

If YES depth of formation
Why
Drillers Remarks:
Yield in gpm: 30
Size pump: 1 1/2 in
Type power:

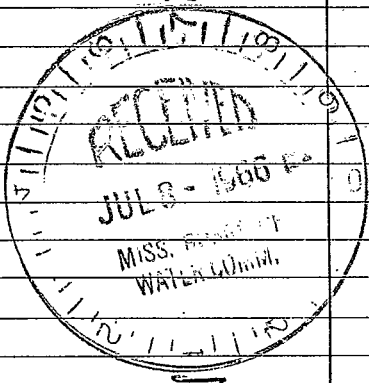

Handwritten signature and 'Total 105'

100  
100  
100