

3 Newton
Jlb
9-66

T

WATER WELL DRILLERS LOG

Date: 9-28, 1966, Driller: J. L. Skelton County Newton
(Name)

(1) Owner of Land: J. A. Bugg
(Name)
Lawrence Miss
(Address)

(2) Location: NE 1/4, SE 1/4, Sec. 15 T. 6 R. 10
5 miles NW, of Lawrence
(distance) (direction) (Nearest Town)

(3) Topography: ✓
(Hilly) (Flat) (Level)

(4) Purpose of Well: Domestic
(Domestic Irrigation
Municipal, Industrial, Other)

Description & Color of Materials Sand, Clay, Red Clay, Shell, etc.	Thick- ness Feet	Depth Feet
<u>Yellow clay</u>	<u>20</u>	<u>0-20</u>
<u>B clay</u>	<u>33</u>	<u>20-53</u>
<u>B sandy</u>	<u>21</u>	<u>53-74</u>
<u>Gravel</u>	<u>30</u>	<u>74-104</u>

Information upon completion of well:

(1) Diameter 2 inches.

(2) Total Depth 104 feet.

(3) Water Level 28 feet below top of ground.

(4) Cased to 104, Size 2


(5) Screen: Size 60#, Length 6

(6) Were any formations sealed against pollution?
no

If YES depth of formation _____

Why _____

Drillers Remarks: _____

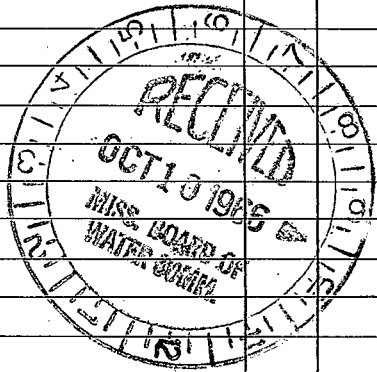

Well No. 118

(Use Back Side)

[Faint, illegible text, possibly bleed-through from the reverse side of the page]