

J-17  
10-66

WATER WELL DRILLERS LOG

Date: 10-28, 1966, Driller: Forest Dilling, County: Newton  
(Name)

(1) Owner of Land: James W. Carr  
 (Name)  
 RT1 Lawrence, Miss  
 (Address)

(2) Location: SW 1/4 NW 1/4, Sec. 22, T6N, R2E  
3 miles North, of Lawrence  
 (distance) (direction) (Nearest Town)

(3) Topography:  (Hilly)  (Flat)  (Level)

(4) Purpose of Well: Home  
 (Domestic Irrigation, Municipal, Industrial, Other)

Description & Color of Materials Sand, Clay, Red Clay, Shell, etc.	Thick- ness Feet	Depth Feet
<u>Red Clay</u>	<u>0</u>	<u>12</u>
<u>Clay + mky sand</u>	<u>18</u>	<u>30</u>
<u>Clay</u>	<u>30</u>	<u>60</u>
<u>Fine sand + silt clay</u>	<u>21</u>	<u>81</u>
<u>Fine sand</u>	<u>14</u>	<u>95</u>

Information upon completion of well:

(1) Diameter 2 inches.

(2) Total Depth 95 feet.

(3) Water Level 12 feet below top of ground.

(4) Cased to 85, Size 2"


(5) Screen: Size 2", Length 10ft

(6) Were any formations sealed against pollution?  
 yes,  no.

If YES depth of formation \_\_\_\_\_

Why \_\_\_\_\_

Drillers Remarks: \_\_\_\_\_

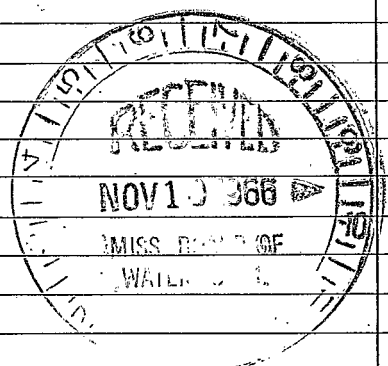

(Use Back Side)

Well No.

