

2

7

| |
|--------|
| Newton |
| J 19 |
| 3-67 |
| |

MISSISSIPPI
 BOARD OF WATER COMMISSIONERS
 416 North State Street
 Jackson, Mississippi 39201

WATER WELL DRILLERS LOG

3-29-67 date well completed Wilkerson Drilling firm name Newton county well located

LANDOWNER: Claude Brown

| description of formations encountered | from | to |
|---------------------------------------|---------------------|--------|
| | CLAY & SAND SAND | 0 5 |


LAKE MISS (mailing address)

WELL LOCATION:
 sec. 4 T. 10 N. R. 10 E.
6 S. W.
5 miles NE of LAKE
 (distance) (direction) (nearest town)

WELL PURPOSE: home
 (home, irrigation, municipal, industrial)

WELL COMPLETION DATA:


- (1) diameter (inches) 2"
- (2) total depth (feet) 86
- (3) static water level (feet) 45 below top of ground.
- (4) casing 2" GALV 80, (material) (depth)
2" if telescope see back. (size)
- (5) screen 6, 80 (length) (depth to top)
85 ft
2" (size), BRASS (material)
- (6) pump 1/2 (HP), 350 (yield gpm)
Elec (type power)
- (7) electric log No (yes or no)
 (organization running log)
- (8) how well bottom plugged BWV

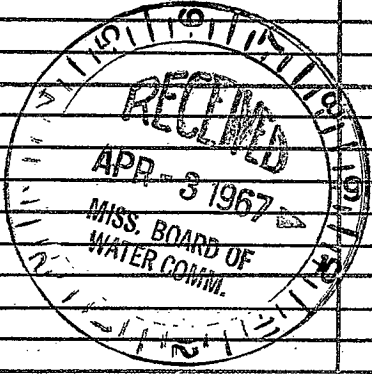

DRILLERS REMARKS:

If well telescopes please sketch and show depths.

GROUND LEVEL

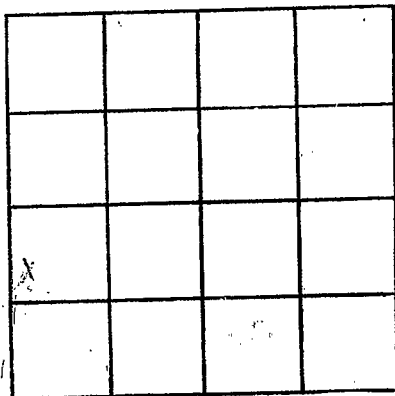

SECTION 4

Please indicate well location X.

ADDITIONAL INFORMATION

If more than one screen,
show locations of each on sketch.