

Newton
T 20
1-68

MISSISSIPPI
BOARD OF WATER COMMISSIONERS
416 North State Street
Jackson, Mississippi 39201

WATER WELL DRILLERS LOG

JAN 20 19 68 Wilkerson Drilling Newton
date well completed firm name county well located

LANDOWNER: V. M. Roebuck

description of formations encountered

from to

LAKE MISS

CLAY
SAND & CLAY
ROCK
SAND

0 10
10 20
20 21
21 75

(mailing address)

WELL LOCATION: SE NW NE


sec 5 T 6 (N) R 10 (E)
Highway 5
6 miles N.E. of LAKE
(distance) (direction) (nearest town)

WELL PURPOSE: home
(home, irrigation, municipal, industrial)

WELL COMPLETION DATA:


- (1) diameter (inches) 2"
- (2) total depth (feet) 75
- (3) static water level (feet) 20 below above top of ground.
- (4) casing Galv., 69,
(material) (depth)
2" if telescope see back.
(size)
- (5) screen 6, 69
(length) (depth to top)
2", BRASS
(size) (material)
- (6) pump 1/2, 7
(HP) (yield gpm)
51cc
(type power)
- (7) electric log NO
(yes or no)
(organization running log)
- (8) how well bottom plugged 2" B.W.V.

DRILLERS REMARKS:

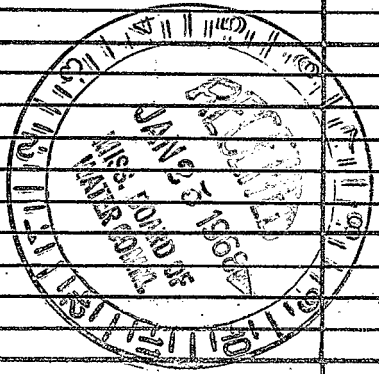

If well telescopes please sketch and show depths.

GROUND LEVEL

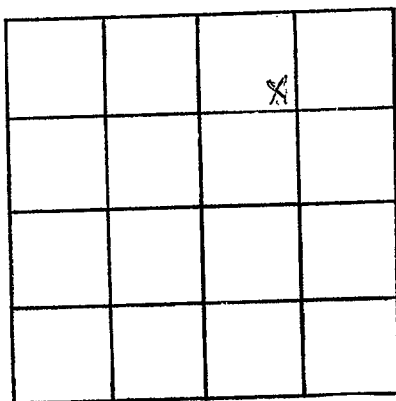

SECTION 5

Please indicate well location X.

ADDITIONAL INFORMATION

If more than one screen,
show locations of each on sketch.