

3 KJ22
11-18-63

WATER WELL DRILLERS LOG

Date: 11-18, 1963, Driller: J. L. Hall County Newton
(Name)

(1) Owner of Land: L. C. Craven
(Name)
Newton Miss.
(Address)

(2) Location: NW 1/4, SE 1/4, Sec. 13 T6 R18
5 miles NN, of Newton
(distance) (direction) (Nearest Town)

(3) Topography: (Hilly) (Flat) (Level)

(4) Purpose of Well: Domestic
(Domestic Irrigation
Municipal, Industrial, Other)

Description & Color of Materials Sand, Clay, Red Clay, Shell, etc.	Thick- ness Feet	Depth, Feet
Sand clay	18	0-18
Blue Sand	56	18-74
	32	74-106

Information upon completion of well:

(1) Diameter: 3 1/2 inches.

(2) Total Depth: 106 feet.

(3) Water Level: 78 feet below top of ground.


(4) Cased to: 106, Size: 2"

(5) Screen: Size: 2", Length: 10'

(6) Were any formations sealed against pollution?
_____ yes, no.

If YES depth of formation _____
Why _____

Drillers' Remarks: _____

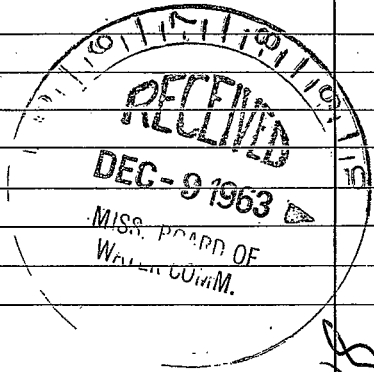

Handwritten initials/signature

Well No.

(Use Back Side)

