

CODED

*Under*

<i>Newton</i>
<i>J 23</i>
<i>10-25-68</i>

MISSISSIPPI  
BOARD OF WATER COMMISSIONERS  
416 North State Street  
Jackson, Mississippi 39201

CODED

WATER WELL DRILLERS LOG

*Oct 25* 19*68* *Wilkinson Drilling* *Newton*  
 date well completed firm name county well located

LANDOWNER: *Richard*  
*MANN*

description of formations encountered	from	to
<i>yellow CLAY</i>	<i>0</i>	<i>10</i>
<i>yellow CLAY &amp; Sand</i>	<i>10</i>	<i>35</i>
<i>blue CLAY</i>	<i>35</i>	<i>105</i>
<i>bedded CLAY &amp; Sand</i>	<i>105</i>	<i>125</i>
<i>Rock &amp; Sand</i>	<i>125</i>	<i>132</i>
<i>SAND</i>	<i>120</i>	<i>165</i>

*Lawrence, MISS*  
(mailing address)

WELL LOCATION:  
 sec *24* T *6* N R *10* E  
           *S*          W  
*2 1/2* miles *North* of *Lawrence*  
 (distance) (direction) (nearest town)

WELL PURPOSE: *home*  
 (home, irrigation, municipal, industrial)

WELL COMPLETION DATA:


- (1) diameter (inches) *2*
- (2) total depth (feet) *165*
- (3) static water level (feet) *50* below above  
top of ground.
- (4) casing *GALV.*, *160*,  
(material) (depth)  
         if telescope see back.  
(size)
- (5) screen *5*, *165*  
(length) (depth to top)  
*2*, *BRASS*  
(size) (material)
- (6) pump *1* *7*  
(HP) (yield gpm)  
*Elec*  
(type power)
- (7) electric log *NO*  
(yes or no)  
          
(organization running log)
- (8) how well bottom plugged *2" R.W.*

DRILLERS REMARKS:

REC - 5 1968  
 MISS. DE. OF  
 WATER CONSERV.

If well telescopes please sketch and show depths.

GROUND LEVEL

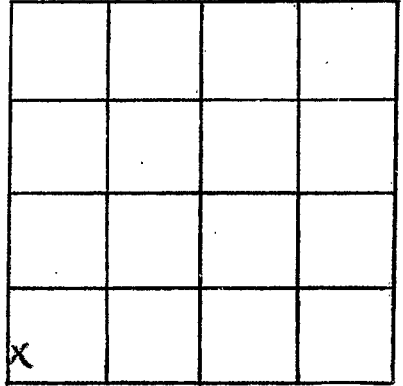

SECTION 24

Please indicate well location X.

ADDITIONAL INFORMATION

If more than one screen, show locations of each on sketch.