

Code

MISSISSIPPI BOARD OF WATER COMMISSIONERS  
416 North State Street  
Jackson, Mississippi 39201

CODED

CODED

WATER WELL DRILLERS LOG

Newton  
J24  
11-68

NOV 19 68 Wilkercod Drilling Newton  
date well completed firm name county well located

LANDOWNER: Edward McGowan  
Lawrence MISS  
(mailing address)

description of formations encountered	from	to
	yellow clay	0
yellow clay + sand	15	40
blue clay	40	90
brown clay	90	105
sand	105	132

WELL LOCATION:  
sec. 25<sup>S</sup> T. 6<sup>N</sup> R. 10<sup>E</sup>  
S W  
2 1/4 miles North of Lawrence  
(distance) (direction) (nearest town)

WELL PURPOSE: home  
(home, irrigation, municipal, industrial)

WELL COMPLETION DATA:

- (1) diameter (inches) 2
- (2) total depth (feet) 132
- (3) static water level (feet) 35 below top of ground.
- (4) casing GALV. 126 (material) (depth)
- (size) if telescope see back.
- (5) screen 6 (length) 132 (depth to top)
- 2 (size) brass (material)
- (6) pump 1 (HP) 6 (yield gpm)
- Elec (type power)
- (7) electric log NO (yes or no)

(organization running log)


(8) how well bottom plugged 2" Blk.

DRILLERS REMARKS:

DEC 5 1968  
MISS. BUREAU OF WATER CONTROL

If well telescopes please sketch and show depths.

GROUND LEVEL

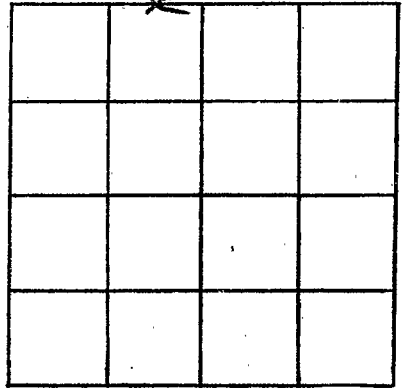

SECTION 25

Please indicate well location X.

ADDITIONAL INFORMATION

If more than one screen, show locations of each on sketch.