

Newton
J 25
1-8-68

MISSISSIPPI
BOARD OF WATER COMMISSIONERS
416 North State Street
Jackson, Mississippi 39201

CODED

WATER WELL DRILLERS LOG

1-8 1968 Common Drilling Co. Newton
date well completed firm name county well located

LANDOWNER: Z. J. Jacobs

description of formations encountered	from	to

Lawrence R#1 Miss

<u>Red Clay</u>	<u>0</u>	<u>30</u>
<u>Red sand</u>	<u>30</u>	<u>38</u>
<u>Strawberry Chalk</u>	<u>38</u>	<u>70</u>

(mailing address)

WELL LOCATION:

sec. 23 T. 6 N R. 10 E
S W
6 miles 5 of CONNAUGHT
(distance) (direction) (nearest town)

<u>Rock</u>	<u>70</u>	<u>72</u>
<u>Dark sand</u>	<u>72</u>	<u>79</u>
<u>Clay</u>	<u>79</u>	<u>180</u>

WELL PURPOSE: Home
(home, irrigation, municipal, industrial)

<u>White sand</u>	<u>180</u>	<u>267</u>
<u>Clay</u>	<u>267</u>	<u>390</u>

WELL COMPLETION DATA:

(1) diameter (inches) 2"
(2) total depth (feet) 500
(3) static water level (feet) 155 below above
top of ground.
(4) casing Steel, 4.25,
(material) (depth)

<u>Sand</u>	<u>390</u>	<u>408</u>
<u>Clay</u>	<u>408</u>	<u>426</u>
<u>Black + sand</u>		
<u>Ledges</u>	<u>450</u>	<u>478</u>
<u>Green sand</u>	<u>478</u>	<u>500</u>

_____ if telescope see back.
(size)

(5) screen None, _____
(length) (depth to top)

_____ (size) _____ (material)

(6) pump 15 _____
(HP) (yield gpm)

_____ (type power)

(7) electric log X
(yes or no)

_____ (organization running log)

(8) how well bottom plugged _____

DRILLERS REMARKS: Open
Ballroom to
CONNAUGHT SAND.


CODED

FEB 12 1969

MISS. BD. OF
WATER COM.

If well telescopes please
sketch and show depths.

GROUND LEVEL

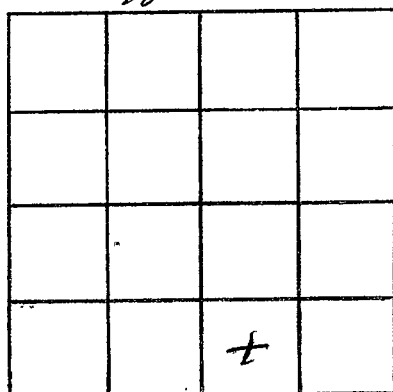

SECTION 23

Please indicate well location X.

ADDITIONAL INFORMATION

If more than one screen,
show locations of each on sketch.