

Newton  
 J 26  
 9-25-68

MISSISSIPPI  
 BOARD OF WATER COMMISSIONERS  
 416 North State Street  
 Jackson, Mississippi 39201

WATER WELL DRILLERS LOG

CODED

9-25 date well completed 1968 Bohannon Drilling Service firm name Newton county well located

LANDOWNER: James Fisher

description of formations encountered

from to

Star Lutett Box 10  
Dale Miss  
 (mailing address)

<u>Clay</u>	<u>10</u>	<u>26</u>
<u>5' clay sand</u>		
<u>+ clay</u>	<u>26</u>	<u>65</u>
<u>Clay + shell</u>	<u>65</u>	<u>82</u>
<u>Coarse sand</u>	<u>82</u>	<u>110</u>

WELL LOCATION:

sec. 5 T. 6 N R. 10 E  
 S W  
3 miles N of Lutke  
 (distance) (direction) (nearest town)

WELL PURPOSE:

(home, irrigation, municipal, industrial)

WELL COMPLETION DATA:

- (1) diameter (inches) 2"
- (2) total depth (feet) 110
- (3) static water level (feet) 65 below above top of ground.
- (4) casing 5" 105'  
 (material) (depth)  
 (size) if telescope see back.
- (5) screen 5 , 105'  
 (length) (depth to top)  
1 1/4" , 45'  
 (size) (material)
- (6) pump 1" 300 GPM  
 (HP) (yield-gpm)  
 (type power)
- (7) electric log \_\_\_\_\_  
 (yes or no)  
 (organization running log)
- (8) how well bottom plugged \_\_\_\_\_

CODED

FEB 12 1969


DRILLERS REMARKS:

MISS. BD. OF  
 WATER COMM

2

If well telescopes please sketch and show depths.

GROUND LEVEL

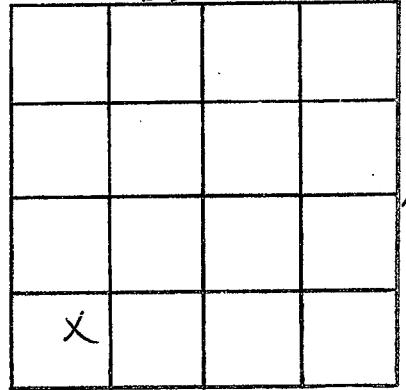

SECTION 5

Please indicate well location X.

ADDITIONAL INFORMATION

A series of horizontal lines for entering additional information.

If more than one screen, show locations of each on sketch.