

MISSISSIPPI
BOARD OF WATER COMMISSIONERS
416 North State Street
Jackson, Mississippi 39201

CODED

WATER WELL DRILLERS LOG

Newton
J 27
9-25-68

9-25 1968 Conroy Drilling Newton
date well completed firm name county well located

LANDOWNER: James Fisher

description of formations encountered from to

Star Route Lake Minn

Dark Clay 0 90

(mailing address)

Fine Sand 90 100

WELL LOCATION:

sec. 18 T. 6 N R. 10 E
S W
2 miles N of Lake
(distance) (direction) (nearest town)

Coarse Sand 100 110

WELL PURPOSE: Home
(home, irrigation, municipal, industrial)

WELL COMPLETION DATA:

(1) diameter (inches) 2"

(2) total depth (feet) 110

(3) static water level (feet) 60 below above top of ground.

(4) casing Steel, 105'
(material) (depth)

CODED

_____ if telescope see back.
(size)

(5) screen 5', 105'
(length) (depth to top)

1/4", 5/32"
(size) (material)

(6) pump 3/4 260
(HP) (yield gpm)

_____ (type power)

(7) electric log X
(yes or no)

_____ (organization running log)

(8) how well bottom plugged Block


FEB 12 1969

DRILLERS REMARKS:

MISS. BD. OF
WATER COMM.

If well telescopes please sketch and show depths.

GROUND LEVEL

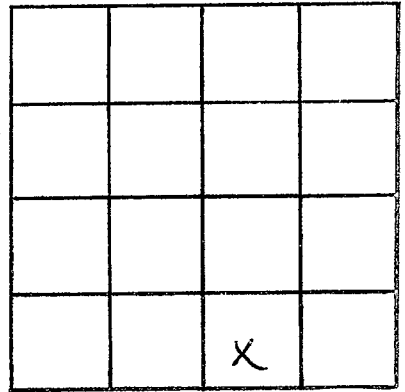

SECTION 18

Please indicate well location X.

ADDITIONAL INFORMATION

If more than one screen, show locations of each on sketch.