

MISSISSIPPI
BOARD OF WATER COMMISSIONERS
416 North State Street
Jackson, Mississippi 39201

WATER WELL DRILLERS LOG

NEWTON
Q. 28
8-12-69

8-12-1969 date well completed U. L. Shelton Newton firm name county well located

LANDOWNER: S. A. Horne
~~Personal~~
~~Miss~~
(mailing address)

description of formations encountered	from	to
Red clay	0	33
Blue	33	64
B. Sand	64	90
Sandy	90	135
Sand	135	157

WELL LOCATION:
sec 23 T 6 N R 10 E
S 5
1 miles N of Lawrence
(distance) (direction) (nearest town)

WELL PURPOSE:
(home, irrigation, municipal, industrial)

WELL COMPLETION DATA:

(1) diameter (inches) 2"

(2) total depth (feet) 157

(3) static water level (feet) 48 below top of ground.

(4) casing 3" (material) (depth) if telescope see back.

(5) screen 9' (length) 5' (depth to top)
2" (size) Brass (material)

(6) pump 1 1/2 (HP) 900 (yield gpm)
Cleu (type power)

(7) electric log (yes or no)
(organization running log)

(8) how well bottom plugged


AUG 18 1969

MISS. BD. OF
WATER COMM.

DRILLERS REMARKS:

If well telescopes please sketch and show depths.

GROUND LEVEL

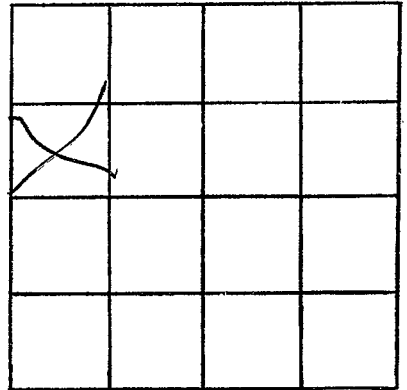

SECTION _____

Please indicate well location X.

ADDITIONAL INFORMATION

If more than one screen, show locations of each on sketch.