

CODED

MISSISSIPPI
BOARD OF WATER COMMISSIONERS
416 North State Street
Jackson, Mississippi 39201

WATER WELL DRILLERS LOG

Newton
J 29
9-10-69

9-10 1969 U. S. Welch Newton
date well completed firm name county well located

LANDOWNER: A.D. MANN

description of formations encountered	from	to
<u>Clay</u>	<u>0</u>	<u>22</u>
<u>Brown</u>	<u>22</u>	<u>64</u>
<u>Grey + sandy</u>	<u>64</u>	<u>129</u>
<u>Sand</u>	<u>129</u>	<u>178</u>

Lawrence
Miss
(mailing address)

WELL LOCATION:

sec. 23 T 6 N R 10 E
S W
1 miles N of Lawrence
(distance) (direction) (nearest town)

WELL PURPOSE: Home
(home, irrigation, municipal, industrial)

WELL COMPLETION DATA:

- (1) diameter (inches) 3"
- (2) total depth (feet) 178
- (3) static water level (feet) 45 below top of ground.
- (4) casing Galvalume,
(material) (depth)
 if telescope see back.
(size)
- (5) screen 10',
(length) (depth to top)
2", Brown
(size) (material)
- (6) pump 1/2 500
(HP) (yield gpm)
Electric
(type power)
- (7) electric log
(yes or no)


(organization running log)
- (8) how well bottom plugged

DRILLERS REMARKS:

SEED 11 1969
MISS. BLD. OF
WATER COMMISSIONERS

If well telescopes please sketch and show depths.

GROUND LEVEL

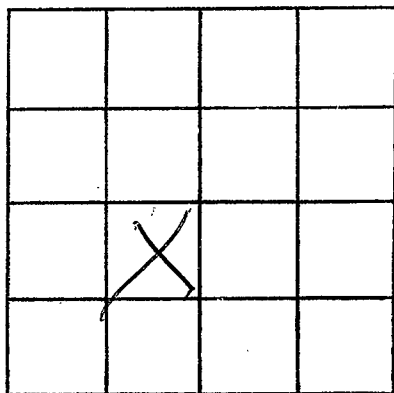

SECTION 23

Please indicate well location X.

ADDITIONAL INFORMATION

If more than one screen, show locations of each on sketch.