

CODED

MISSISSIPPI
BOARD OF WATER COMMISSIONERS
416 North State Street
Jackson, Mississippi 39201

WATER WELL DRILLERS LOG

Newton
J 30
10-69

Oct 1969 Wilkinson Drilling Newton
date well completed firm name county well located

LANDOWNER:

Holleyworth Co.
Lumbance MISS
(mailing address)

description of formations encountered

Clay
SAND

from to

0 20
20 79

WELL LOCATION:

sec. 9 T 6 N R 10 E
S W
4 miles NE of Lake
(distance) (direction) (nearest town)

WELL PURPOSE: home + store
(home, irrigation, municipal, industrial)

WELL COMPLETION DATA:

- (1) diameter (inches) 2
- (2) total depth (feet) 79
- (3) static water level (feet) 19 below above top of ground.
- (4) casing Galv, 75,
(material) (depth)
 if telescope see back.
(size)
- (5) screen 4, 79
(length) (depth to top)
2, STAINLESS
(size) (material)
- (6) pump 1 1/2 11
(HP) (yield gpm)
ELEC
(type power)
- (7) electric log no
(yes or no)

(organization running log)


(8) how well bottom plugged 2 5/8" U

DRILLERS REMARKS:

NOV 27 1969
MISS. DEPT. OF
WATER CONTROL

If well telescopes please sketch and show depths.

GROUND LEVEL

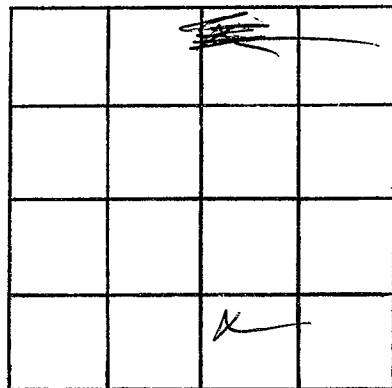

SECTION 9

Please indicate well location X.

ADDITIONAL INFORMATION

If more than one screen, show locations of each on sketch.