

CODED

MISSISSIPPI
BOARD OF WATER COMMISSIONERS
416 North State Street
Jackson, Mississippi 39201

WATER WELL DRILLERS LOG

NEWTON

86 J 31

6-17-69

6-17
date well completed

1969 U. L. Chalch
firm name

Newton
county well located

LANDOWNER: George Robinson

description of formations encountered

from to

Lawrence
Miss
(mailing address)

Yellow Chalky 0 12
Blue 12 44
Blue & Sandy 44 64
Brown 64 75
Grey 75 85
Sand 85 155

WELL LOCATION:

sec. 34 T 6 N R 10 E
S W
1 1/2 miles W of Lawrence
(distance) (direction) (nearest town)

WELL PURPOSE: Home
(home, irrigation, municipal, industrial)

WELL COMPLETION DATA:

- (1) diameter (inches) 2 1/2
- (2) total depth (feet) 155
- (3) static water level (feet) 25 below top of ground.
- (4) casing Gal Steel (material) (depth)
- (size) if telescope see back.
- (5) screen 8' (length) (depth to top)
2" plastic (size) (material)
- (6) pump 1/2 (HP) 350 (yield gpm)
Eber (type power)
- (7) electric log (yes or no)
- (organization running log)
- (8) how well bottom plugged


DRILLERS REMARKS:

JUN 23 1969

MISS. BD. OF
WATER COM.

If well telescopes please sketch and show depths.

GROUND LEVEL

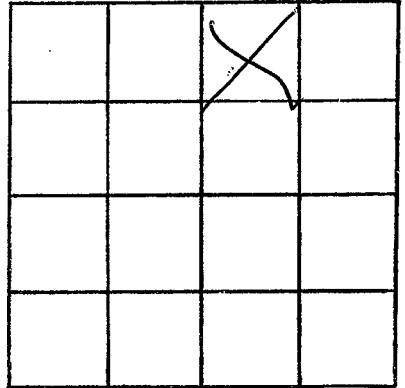

SECTION _____

Please indicate well location X.

ADDITIONAL INFORMATION

If more than one screen,
show locations of each on sketch.