

Newton
 J 32
 12-2-69

MISSISSIPPI
 BOARD OF WATER COMMISSIONERS
 416 North State Street
 Jackson, Mississippi 39201

CODED

CODED

WATER WELL DRILLERS LOG


12/3/69 19 Forest Drilling Newton
 date well completed firm name county well located

LANDOWNER:	description of formations encountered	from	to
C.C. Evans			
Lake, Miss. (mailing address)	Red clay	0	10
	(clay + silt) sand	10	20
	Clay + silt mucky sand	20	81
	Clay	81	143
	fine sand + silt clay	143	163
	(good) sand	163	179
WELL LOCATION: 20 sec. <u>6</u> T <u>6</u> N <u>10</u> E 2 miles <u>NE</u> of <u>Lake</u> (distance) (direction) (nearest town)			
WELL PURPOSE: <u>None</u> (home, irrigation, municipal, industrial)			
WELL COMPLETION DATA:			
(1) diameter (inches) <u>4" x 2"</u>			
(2) total depth (feet) <u>179'</u>			
(3) static water level (feet) <u>50'</u> below above top of ground.			
* (4) casing <u>Steel</u> , <u>168'</u> (material) (depth) <u>4" x 2"</u> if telescope see back. (size)			
(5) screen <u>10'</u> , <u>168'</u> (length) (depth to top)			
<u>2"</u> , <u>Brook C/M</u> (size) (material)			
(6) pump <u>1-1/2</u> Stage <u>12</u> (HP) (field gpm)			
<u>Electric</u> (type power)			
(7) electric log <u>NO</u> (yes or no)			
(organization running log)			
(8) how well bottom plugged <u>2" Backwash Valve</u>			
* DRILLERS REMARKS: <u>147' - 4" Steel Casing</u> <u>21' - 2" Steel Casing</u>			

JAN 9 1970
 MISS. BD. OF WATER COMMISSIONERS

If well telescopes please sketch and show depths.

GROUND LEVEL

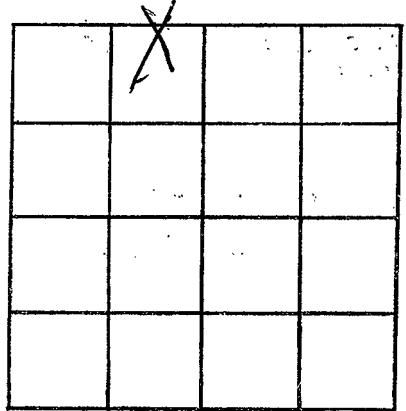

SECTION 20

Please indicate well location X.

ADDITIONAL INFORMATION

If more than one screen,
show locations of each on sketch.