

CODED

CODED

Newton  
833  
12-19-69

MISSISSIPPI  
BOARD OF WATER COMMISSIONERS  
416 North State Street  
Jackson, Mississippi 39201

WATER WELL DRILLERS LOG

12-19 1969 W.H. Shelch Newton  
date well completed firm name county well located

LANDOWNER: Mrs A.G. Rush

description of formations encountered from to

LAKE  
MISS (mailing address)

Clay 0 20  
Blue 20 32  
Gray sandy 32 43  
Sandy 43 86  
Sand 86 99

WELL LOCATION:

sec. 8 T. 6 N. R. 10 E.  
S  
5 N miles N of Dube  
(distance) (direction) (nearest town)

WELL PURPOSE: Home  
(home, irrigation, municipal, industrial)

WELL COMPLETION DATA:

- (1) diameter (inches) 2 1/2
- (2) total depth (feet) 99'
- (3) static water level (feet) 100 below above top of ground.
- (4) casing 4" Steel (material) (depth)  
if telescope see back. (size)
- (5) screen 5' (length) (depth to top)  
2 1/2" (size) Brass (material)
- (6) pump 1/2 (HP) 280 (yield gpm)  
electric (type power)
- (7) electric log ✓ (yes or no)  
(organization running log)
- (8) how well bottom plugged

JAN 1 1970

MISS. BD. OF WATER C.


JAN 16 1970

MISS. BD. OF WATER COMM.

DRILLERS REMARKS:

If well telescopes please sketch and show depths.

GROUND LEVEL

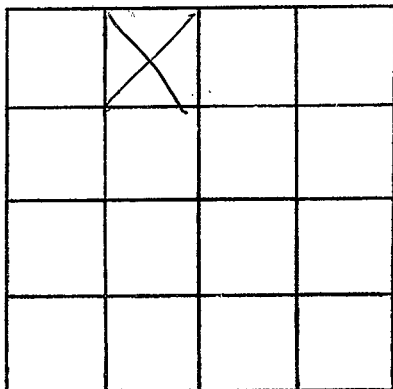

SECTION \_\_\_\_\_

Please indicate well location X.

ADDITIONAL INFORMATION

If more than one screen,  
show locations of each on sketch.