

Newton
 J35
 2-25-70

MISSISSIPPI
 BOARD OF WATER COMMISSIONERS
 416 North State Street
 Jackson, Mississippi 39201

CODED

WATER WELL DRILLERS LOG

2-25 1970 U.L. Kelch Newton
 date well completed firm name county well located

LANDOWNER: A MANN JR.
 Lawrence
 Miss.
 (mailing address)

description of formations encountered	from	to
Red clay	0	12
Yellow clay	12	23
Blue	23	43
Grey	43	118
Grey Sandy	118	128
Gr S	128	157

WELL LOCATION:
 sec 24 T 6 N R 10 E
 4 miles W of Newton
 (distance) (direction) (nearest town)

WELL PURPOSE:
 (home, irrigation, municipal, industrial)

- WELL COMPLETION DATA:
- (1) diameter (inches) 2"
 - (2) total depth (feet) 157
 - (3) static water level (feet) 54 below top of ground.
 - (4) casing 4" steel, 147' (material) (depth)
 (size) If telescope see back.
 - (5) screen 10' (length), (depth to top)
 2" (size), 55' (material)
 - (6) pump 1 (HP), 450 (yield gpm)
 Elec (type power)
 - (7) electric log (yes or no)
 (organization running log)
 - (8) how well bottom plugged

CODED


MAR 13 1970

MISS. Bd. OF WATER COMM.

DRILLERS REMARKS:

If well telescopes please sketch and show depths.

GROUND LEVEL

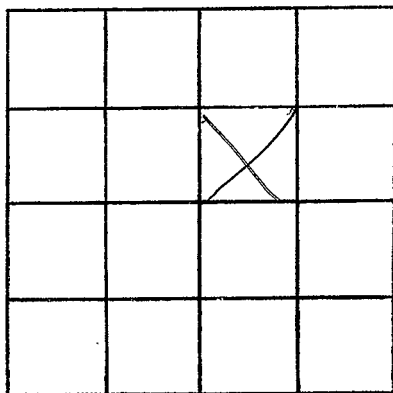

SECTION _____

Please indicate well location X.

ADDITIONAL INFORMATION

If more than one screen,
show locations of each on sketch.