

Newton
J.36
5-1-70

MISSISSIPPI
 BOARD OF WATER COMMISSIONERS
 416 North State Street
 Jackson, Mississippi 39201

WATER WELL DRILLERS LOG

5-1 1970 H. L. Walcott Newton
 date well completed firm name county well located

LANDOWNER: Hene. Higgins

description of formations encountered	from	to
<u>Yellow clay</u>	<u>0</u>	<u>12</u>
<u>Grey</u>	<u>12</u>	<u>22</u>
<u>Grey sand</u>	<u>22</u>	<u>32</u>
<u>Grey</u>	<u>32</u>	<u>75</u>
<u>Grey sandy</u>	<u>75</u>	<u>107</u>
<u>Sand</u>	<u>107</u>	<u>138</u>

Newton
Miss 39345
 (mailing address)

WELL LOCATION: 003
 sec. 22T-6N R. 10E
6 miles NW of Newton
 (distance) (direction) (nearest town)

WELL PURPOSE: Hog Pasture
 (home, irrigation, municipal, industrial)

WELL COMPLETION DATA:

- (1) diameter (inches) 2"
- (2) total depth (feet) 138
- (3) static water level (feet) 22 below above top of ground.
- (4) casing 40 Steel
 (material) (depth)
2" if telescope see back.
 (size)
- (5) screen 7'
 (length) (depth to top)
2", Brass
 (size) (material)
- (6) pump 3 400
 (HP) (yield gpm)
electric
 (type power)
- (7) electric log no
 (yes or no)

(organization running log)

(8) how well bottom plugged


DRILLERS REMARKS:

JUN 1 - 1970

MISS. BD. OF
 WATER COMMISSIONERS

If well telescopes please sketch and show depths.

GROUND LEVEL

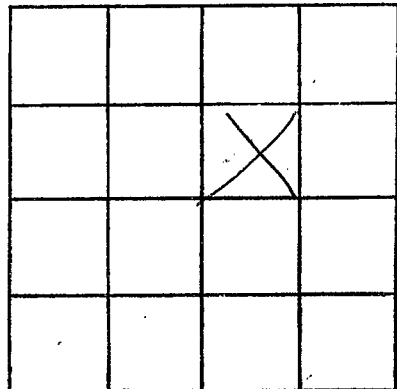

SECTION _____

Please indicate well location X.

ADDITIONAL INFORMATION

If more than one screen, show locations of each on sketch.