

Newton
J 37
5-15-70

MISSISSIPPI
 BOARD OF WATER COMMISSIONERS
 416 North State Street
 Jackson, Mississippi 39201

WATER WELL DRILLERS LOG

5-15 1970 Newton Newton
 date well completed firm name county well located

LANDOWNER: C.H. Thomas

Description of formations encountered	from	to
<u>Lawrence</u>	<u>0</u>	<u>22</u>
<u>Blue</u>	<u>22</u>	<u>43</u>
<u>Blue + sandy</u>	<u>43</u>	<u>64</u>
<u>Sand</u>	<u>64</u>	<u>90</u>

Lawrence
Miss 39336
 (mailing address)

WELL LOCATION: 003
 sec 14 T 6N R 10E
3 miles NW of Lawrence
 (distance) (direction) (nearest town)

WELL PURPOSE: Drain
 (home, irrigation, municipal, industrial)


- WELL COMPLETION DATA:
- (1) diameter (inches) 2"
 - (2) total depth (feet) 90
 - (3) static water level (feet) 12 below above top of ground.
 - (4) casing Gal Steel (material), (depth)
 - 2" (size) if telescope see back.
 - (5) screen 5' (length), (depth to top)
2" (size), SS (material)
 - (6) pump 3 (HP), 300 (yield gpm)
elec (type power)
 - (7) electric log _____ (yes or no)
 _____ (organization running log)
 - (8) how well bottom plugged _____

DRILLERS REMARKS:

NOV 2 1970
 MISS. BD. OF WATER COMMISSIONERS

If well telescopes please sketch and show depths.

GROUND LEVEL

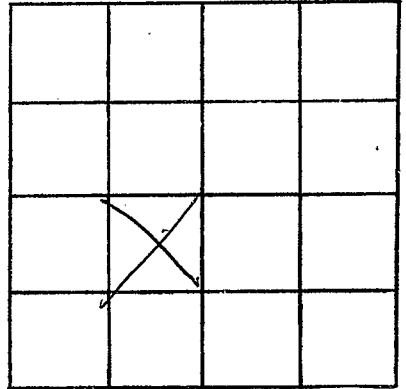

SECTION _____

Please indicate well location X.

ADDITIONAL INFORMATION

If more than one screen,
show locations of each on sketch.