

Newton
J 38
6-20-70

MISSISSIPPI
 BOARD OF WATER COMMISSIONERS
 416 North State Street
 Jackson, Mississippi 39201

CODED

WATER WELL DRILLERS LOG

6-20- 1970 Williamson Drilling & Newton firm name Newton county well located

LANDOWNER Billy Street
Pop. 1
Chumby Miss.
 (mailing address)

description of formations encountered	from	to
<u>top soil</u>	<u>0</u>	<u>3</u>
<u>White sand</u>	<u>3</u>	<u>20</u>
<u>Blue clay</u>	<u>20</u>	<u>42</u>
<u>rock & clay</u>	<u>42</u>	<u>110</u>
<u>sand</u>	<u>110</u>	<u>150</u>

WELL LOCATION:
 sec 35 T 6 N R 13 E
1/4 miles west of Chumby
 (distance) (direction) (nearest town)

WELL PURPOSE: Home
 (home, irrigation, municipal, industrial)

- WELL COMPLETION DATA:
- (1) diameter (inches) 4
 - (2) total depth (feet) 150
 - (3) static water level (feet) 8 below above top of ground.
 - (4) casing Black 35
 (material) (depth)
4 If telescope see back.
 (size)
 - (5) screen no
 (length) (depth to top)
 (size) (material)
 - (6) pump 1/2 7
 (HP) (yield gpm)
elect
 (type power)
 - (7) electric log no
 (yes or no)
no
 (organization running log)
 - (8) how well bottom plugged open

CODED


JUL 24 1970

MISS. BD. OF
 WATER COMM.

DRILLERS REMARKS:

If well telescopes please sketch and show depths.

GROUND LEVEL

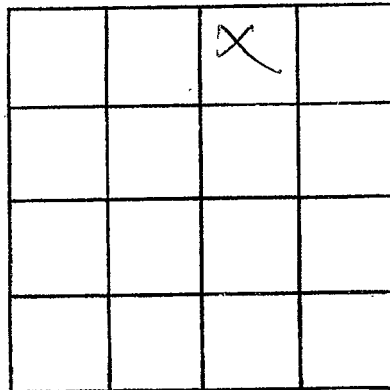

SECTION X

Please indicate well location X.

ADDITIONAL INFORMATION

If more than one screen, show locations of each on sketch.