

Newton
J 39
7-16-70

MISSISSIPPI
BOARD OF WATER COMMISSIONERS
416 North State Street
Jackson, Mississippi 39201

CODED

WATER WELL DRILLERS LOG

7-16 1970 U.L. Halditch Newton
date well completed firm name county well located

LANDOWNER: R.K. Betsill

description of formations encountered	from	to
---------------------------------------	------	----

LAWRENCE
MISS
(mailing address)

Yellow clay	0	22
Blues	22	32
Brown	32	43
Brown + Sa. dy	43	64
Grey	64	96
Grey + Sand	96	128
White sand	128	170

WELL LOCATION:
sec. 25 T 6 N R 10 E
5 miles W of Newton
(distance) (direction) (nearest town)

WELL PURPOSE: Stock Wood
(home, irrigation, municipal, industrial)

WELL COMPLETION DATA:

- (1) diameter (inches) 2"
- (2) total depth (feet) 170
- (3) static water level (feet) 30 below top of ground.
- (4) casing 4" steel 160 (material) (depth)
- (size) if telescope see back.
- (5) screen 10' (length) (depth to top)
- 2" (size) (material)
- (6) pump 2 (HP) 1000 (yield bpm)
- elec. (type power)
- (7) electric log (yes or no)
- (organization running log)
- (8) how well bottom plugged

CODED


JUL 20 1970

MISS. Bd. OF WATER COMMISSIONERS

DRILLERS REMARKS:

If well telescopes please sketch and show depths.

GROUND LEVEL

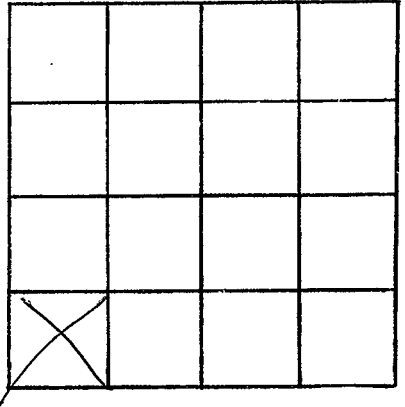

SECTION _____

Please indicate well location X.

ADDITIONAL INFORMATION

If more than one screen, show locations of each on sketch.