

NEWTON

J 40

10-9-70

MISSISSIPPI BOARD OF WATER COMMISSIONERS
416 North State Street
Jackson, Mississippi 39201

CODED

WATER WELL DRILLERS LOG

10-9

1970

J. S. Stroh

Newton

date well completed

firm name

county well located

LANDOWNER: Roger Harrison

description of formations encountered

from

to

Lawrence

Miss

(mailing address)

Brown
Shale
S.S.

0 19
19 39
39 99

WELL LOCATION:

sec. 15 T. 6 S. R. 10 E.

3 miles NW of Lawrence
(distance) (direction) (nearest town)

WELL PURPOSE: Home
(home, irrigation, municipal, industrial)

WELL COMPLETION DATA:

- (1) diameter (inches) 2 1/2
- (2) total depth (feet) 99
- (3) static water level (feet) _____ below above top of ground.

(4) casing 2 1/2" S.S. (material) (depth)

(size) if telescope see back.

(5) screen 10' (length) (depth to top)

2 1/2" S.S. (size) (material)

(6) pump _____ (HP) _____ (yield gpm)

(type power)

(7) electric log _____ (yes or no)

(organization running log)

(8) how well bottom plugged _____

CODED

OCT 30 1970


MISS. DEPT. OF WATER CONTROL

DRILLERS REMARKS:

Customer
Inst Pump

If well telescopes please sketch and show depths.

GROUND LEVEL

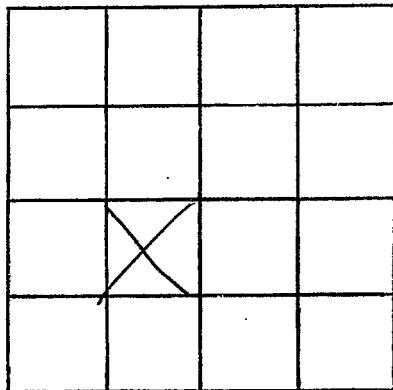

SECTION _____

Please indicate well location X.

ADDITIONAL INFORMATION

If more than one screen, show locations of each on sketch.