

NEWTON
 JA1
 11-5-70

MISSISSIPPI
 BOARD OF WATER COMMISSIONERS
 416 North State Street
 Jackson, Mississippi 39201

CODED

WATER WELL DRILLERS LOG

11-5 date well completed 1970 H. H. Shelch firm name Newton county well located

LANDOWNER: Olen Coakley
Lawrence
Miss
 (mailing address)

description of formations encountered	from to	
	feet	feet
G. clay	0	20
Grey clay	20	60
Sandy	60	80
Sand	80	120

WELL LOCATION:
 sec. 9 T. 6 N. R. 10 E.
6 miles NW of Lawrence
 (distance) (direction) (nearest town)

WELL PURPOSE: Home
 (home, irrigation, municipal, industrial)

- WELL COMPLETION DATA:
- (1) diameter (inches) 2 1/2
 - (2) total depth (feet) 120
 - (3) static water level (feet) 23 below above top of ground.
 - (4) casing Steel (material) (depth)
 (size) if telescope see back.
 - (5) screen 6' (length) (depth to top)
2" (size) 2 Steel (material)
 - (6) pump 1/2 (HP) 400 (yield gpm)
elec (type power)
 - (7) electric log NO (yes or no)
 (organization running log)
 - (8) how well bottom plugged


CODED

DRILLERS REMARKS:

NOV 30 1970

If well telescopes please sketch and show depths.

GROUND LEVEL

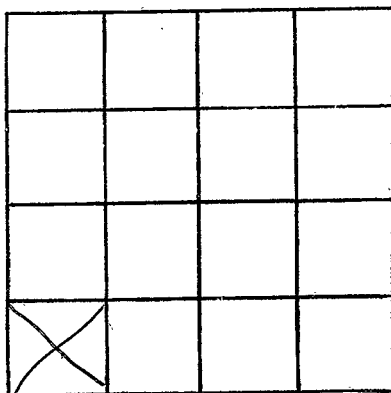

SECTION _____

Please indicate well location X.

ADDITIONAL INFORMATION

If more than one screen, show locations of each on sketch.