

NEWTON
J43
12-20-70

MISSISSIPPI
 BOARD OF WATER COMMISSIONERS
 416 North State Street
 Jackson, Mississippi 39201

CODED

WATER WELL DRILLERS LOG

12-20 1970 W. L. Stroh Newton
 date well completed firm name county well located

LANDOWNER: O. Jones
Lawrence
Miss
 (mailing address)

description of formations encountered	from	to
<u>Yellow clay</u>	<u>0</u>	<u>20</u>
<u>Blue</u>	<u>20</u>	<u>60</u>
<u>Bluish sand</u>	<u>60</u>	<u>80</u>
<u>Sand</u>	<u>80</u>	<u>115</u>

WELL LOCATION:
 sec. 12T 6N R10E
3 miles NW of Princeton
 (distance) (direction) (nearest town)

WELL PURPOSE: Frame
 (home, irrigation, municipal, industrial)

- WELL COMPLETION DATA:
- diameter (inches) 2"
 - total depth (feet) 115
 - static water level (feet) 98 below above top of ground.
 - casing 40 S. (material) (depth)
 (size) if telescope see back.
 - screen 10' (length) (depth to top)
2" (size) S. Steel (material)
 - pump _____ (HP) (yield-gpm)
 (type power)
 - electric log (yes or no) _____
 (organization running log) _____
 - how well bottom plugged _____

CODED


JAN 25 1971

DRILLERS REMARKS: Customer
is going to
install pump

MISS. BD. OF
 WATER COMM.

If well telescopes please sketch and show depths.

GROUND LEVEL

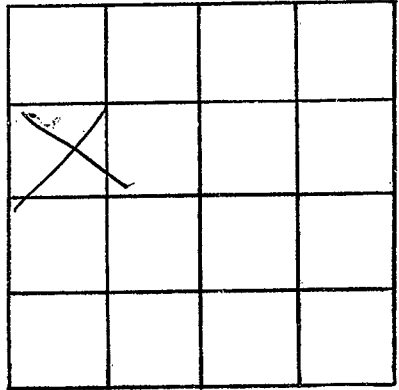

SECTION _____

Please indicate well location X.

ADDITIONAL INFORMATION

If more than one screen,
show locations of each on sketch.