

CODED

MISSISSIPPI
BOARD OF WATER COMMISSIONERS
416 North State Street
Jackson, Mississippi 39201

MAR 26 1971

MISS. BD. OF
WATER COMM.

WATER WELL DRILLERS LOG

NEWTON
544
3-22-71


3-22 1971 71 L Shalobh Newton
date well completed firm name county well located

LANDOWNER: <u>Mason Dennis</u>	description of formations encountered		from	to
<u>Lawrence</u>	<u>Yellow Clay</u>		<u>0</u>	<u>40</u>
<u>Miss</u> (mailing address)	<u>Blue</u>		<u>40</u>	<u>60</u>
WELL LOCATION: sec <u>36</u> T <u>6N</u> R <u>10E</u>	<u>Blue + Sandy</u>		<u>60</u>	<u>100</u>
<u>1/4</u> miles <u>W</u> of <u>Lawrence</u> (distance) (direction) (nearest town)	<u>Sandy</u>		<u>100</u>	<u>130</u>
WELL PURPOSE: <u>Home</u> (home, irrigation, municipal, industrial)	<u>Sand</u>		<u>140</u>	<u>181</u>
WELL COMPLETION DATA: (1) diameter (inches) <u>3"</u>				
(2) total depth (feet) <u>178</u>				
(3) static water level (feet) <u>27</u> below above top of ground.				
(4) casing <u>Gal Steel</u> (material) (depth)				
(size) if telescope see back.				
(5) screen <u>10'</u> (length) (depth to top)				
<u>3"</u> (size) <u>Copper</u> (material)				
(6) pump <u>2'</u> <u>1300</u> (HP) (yield gpm)				
<u>elec</u> (type power)				
(7) electric log (yes or no)				
(organization running log)				
(8) how well bottom plugged				
DRILLERS REMARKS: <u>pumping with</u> <u>air</u>				

CODED

If well telescopes please sketch and show depths.

GROUND LEVEL

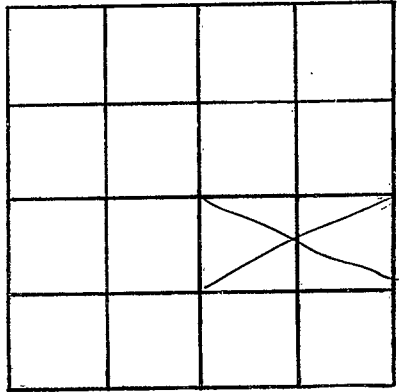

SECTION _____

Please indicate well location X.

ADDITIONAL INFORMATION

If more than one screen, show locations of each on sketch.