

NEWTON  
J 45  
5-26-71

MISSISSIPPI  
 BOARD OF WATER COMMISSIONERS  
 416 North State Street  
 Jackson, Mississippi 39201

**CODED**

WATER WELL DRILLERS LOG

5-26 1971 H. S. Shaleh Newton  
 date well completed firm name county well located

LANDOWNER: R. Walker  
Lawrence  
Miss  
 (mailing address)

description of formations encountered	from to	
	feet	feet
<u>Yellow clay</u>	<u>0</u>	<u>60</u>
<u>yellow sandy</u>	<u>60</u>	<u>120</u>
<u>sand</u>	<u>120</u>	<u>161</u>

WELL LOCATION:  
 sec. 26 T. 4N R. 10E  
3 miles NW of Lawrence  
 (distance) (direction) (nearest town)

WELL PURPOSE: Home  
 (home, irrigation, municipal, industrial)

- WELL COMPLETION DATA:
- (1) diameter (inches) 3"
  - (2) total depth (feet) 161
  - (3) static water level (feet) 37 below above top of ground.
  - (4) casing 3" S Steel (material) (depth)  
 (size) If telescope see back.
  - (5) screen 6 (length) (depth to top)  
3" S Steel (size) (material)
  - (6) pump 1/2 (HP) 400 (yield gpm)  
900w (type power)
  - (7) electric log no (yes or no)  
 (organization running log)
  - (8) how well bottom plugged

**CODED**


DRILLERS REMARKS:

JUN 27 1971

MISS. DEPT. OF WATER CONTROL

If well telescopes please sketch and show depths.

GROUND LEVEL

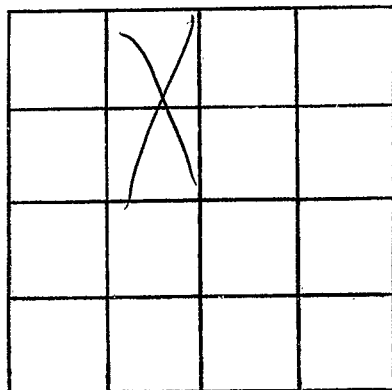

SECTION \_\_\_\_\_

Please indicate well location X.

ADDITIONAL INFORMATION

If more than one screen,  
show locations of each on sketch.