

Newton
J-49
7-13-71

MISSISSIPPI
 BOARD OF WATER COMMISSIONERS
 416 North State Street
 Jackson, Mississippi 39201

CODED

WATER WELL DRILLERS LOG

7-13 1971 H. L. Welch Newton
 date well completed firm name county well located

LANDOWNER: C. Bell
Newton
Miss
 (mailing address)

description of formations encountered	from	to
<u>Yellow Dry</u>	<u>0</u>	<u>16</u>
<u>Blue</u>	<u>16</u>	<u>40</u>
<u>Blue Sandy</u>	<u>40</u>	<u>65</u>
<u>Brown</u>	<u>65</u>	<u>100</u>
<u>Br Sandy</u>	<u>100</u>	<u>120</u>
<u>Sand</u>	<u>120</u>	<u>152</u>

WELL LOCATION:
 sec. 34 T. 6N S. R. 10E
2 miles W of Newton
 (distance) (direction) (nearest town)

WELL PURPOSE: Home
 (home, irrigation, municipal, industrial)

- WELL COMPLETION DATA:
- (1) diameter (inches) 3"
 - (2) total depth (feet) 152
 - (3) static water level (feet) 32 below top of ground
 - (4) casing Gal Steel (material) (depth) _____
 _____ if telescope see back. (size)
 - (5) screen 6 (length) (depth to top) _____
3" (size) 2. Steel (material)
 - (6) pump 1 (HP) 500 (yield gpm)
000 (type power)
 - (7) electric log no (yes or no)
 - (organization running log) _____
 - (8) how well bottom plugged _____

CODED


AUG 3 1971

MISS. BD. OF
 WATER COMM.

DRILLERS REMARKS: _____

If well telescopes please sketch and show depths.

GROUND LEVEL

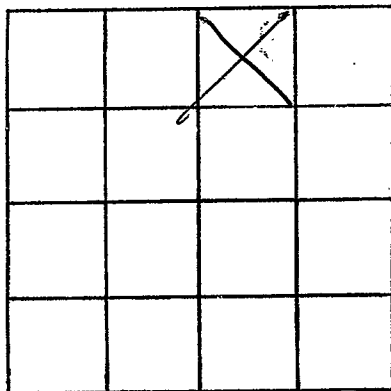

SECTION _____

Please indicate well location X.

ADDITIONAL INFORMATION

If more than one screen,
show locations of each on sketch.