

Newton  
J-50  
7-14-71

MISSISSIPPI  
 BOARD OF WATER COMMISSIONERS  
 416 North State Street  
 Jackson, Mississippi 39201

**CODED**

WATER WELL DRILLERS LOG

7-14 1971 U. L. Shelton Newton  
 date well completed firm name county well located

LANDOWNER: J. Mitchell  
Lawrence  
Miss  
 (mailing address)

description of formations encountered	from	to
<u>Clay</u>	<u>0</u>	<u>20</u>
<u>Blue</u>	<u>20</u>	<u>60</u>
<u>Blue + Sand</u>	<u>60</u>	<u>80</u>
<u>Sand</u>	<u>80</u>	<u>131</u>

WELL LOCATION:  
 sec. 17 T 6 N R 10E  
4 miles NW of Lawrence  
 (distance) (direction) (nearest town)

WELL PURPOSE: home  
 (home, irrigation, municipal, industrial)

- WELL COMPLETION DATA:
- (1) diameter (inches) 3"
  - (2) total depth (feet) 131
  - (3) static water level (feet) 27 below above top of ground.
  - (4) casing 3/4" steel  
 (material) (depth)  
 (size) If telescope see back.
  - (5) screen 5  
 (length) (depth to top)  
2 1/2" 5" steel  
 (size) (material)
  - (6) pump \_\_\_\_\_  
 (HP) (yield gpm)  
 (type power)
  - (7) electric log (yes or no) \_\_\_\_\_  
 (organization running log) \_\_\_\_\_
  - (8) how well bottom plugged \_\_\_\_\_

**CODED**


AUG 3 1971

MISS. BD. OF  
 WATER COMMISSIONERS

DRILLERS REMARKS:  
umping with  
air

If well telescopes please sketch and show depths.

GROUND LEVEL

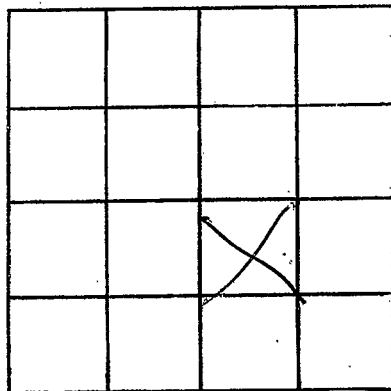

SECTION \_\_\_\_\_

Please indicate well location X.

ADDITIONAL INFORMATION

If more than one screen,  
show locations of each on sketch.