

Newton  
J-51  
7-15-71

MISSISSIPPI  
 BOARD OF WATER COMMISSIONERS  
 416 North State Street  
 Jackson, Mississippi 39201

WATER WELL DRILLERS LOG

**CODED**

7-15 1971 Ed. L. Skelch Newton  
 date well completed firm name county well located

LANDOWNER: J. B. Roberson  
Lawrence  
Miss  
 (mailing address)

description of formations encountered	from	to
<u>Clay</u>	<u>0</u>	<u>15</u>
<u>Blue</u>	<u>15</u>	<u>40</u>
<u>Blue Sand</u>	<u>40</u>	<u>60</u>
<u>Sand</u>	<u>60</u>	<u>91</u>

WELL LOCATION:  
 sec. 14 T. 6N R. 10E  
3 miles NW of Lawrence  
 (distance) (direction) (nearest town)

WELL PURPOSE: Home  
 (home, irrigation, municipal, industrial)

WELL COMPLETION DATA:  
 (1) diameter (inches) 2"  
 (2) total depth (feet) 91  
 (3) static water level (feet) 14 below above top of ground  
 (4) casing Gal Steel  
 (material) (depth)  
 (size) if telescope see back.  
 (5) screen 5  
 (length) (depth to top)  
2" 5'  
 (size) (material)  
 (6) pump 1 500  
 (HP) (yield gpm)  
plastic  
 (type power)  
 (7) electric log no  
 (yes or no)  
 (organization running log)

**CODED**

(8) how well bottom plugged \_\_\_\_\_


AUG 3 1971

DRILLERS REMARKS:

MISS. BD. OF  
 WATER COM'RS

If well telescopes please sketch and show depths.

GROUND LEVEL

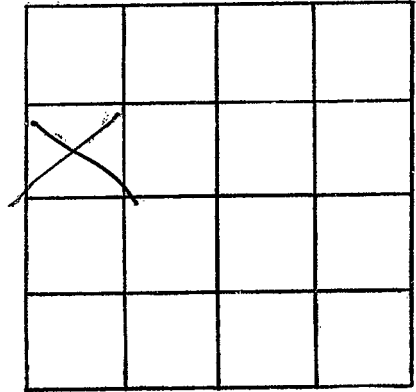

SECTION \_\_\_\_\_

Please indicate well location X.

ADDITIONAL INFORMATION

If more than one screen, show locations of each on sketch.