

NEWTON  
J-52  
7-14-71

MISSISSIPPI  
 BOARD OF WATER COMMISSIONERS  
 416 North State Street  
 Jackson, Mississippi 39201

**CODED**

**WATER WELL DRILLERS LOG**

date well completed July 14 1971 firm name Wilkinson Drilling Service county well located Newton

LANDOWNER: Thurman Pace  
Route  
Lake, Miss  
 (mailing address)

description of formations encountered	from	to
<u>yellow clay</u>	<u>0</u>	<u>20</u>
<u>sandy clay</u>	<u>20</u>	<u>100</u>
<u>water bearing sand</u>	<u>100</u>	<u>126</u>

WELL LOCATION:  
 sec. 8 T. 6 N R. 10 E  
3 miles n of Lake  
 (distance) (direction) (nearest town)

WELL PURPOSE:  
 (home, irrigation, municipal, industrial)

- WELL COMPLETION DATA:
- diameter (inches) 2"
  - total depth (feet) 126
  - static water level (feet) 50 below above top of ground.
  - casing galv 126  
(material) (depth)  
(size) if telescope see back.
  - screen 5T 121  
(length) (depth to top)  
2" 8. steel  
(size) (material)
  - pump 1 1/2 12  
(HP) (yield gpm)  
Elec  
(type power)
  - electric log no  
(yes or no)  
(organization running log)
  - how well bottom plugged B.W.V.

**CODED**


AUG 5 - 1971

DRILLERS REMARKS:

MISS. BD. OF WATER COMM.

If well telescopes please sketch and show depths.

GROUND LEVEL

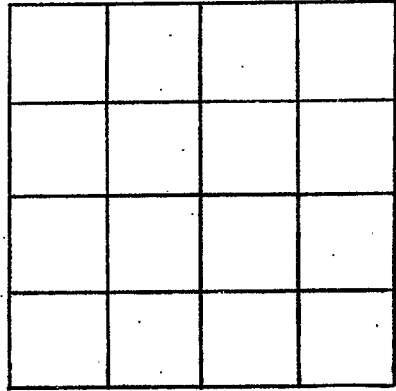

SECTION \_\_\_\_\_

Please indicate well location X.

ADDITIONAL INFORMATION

If more than one screen,  
show locations of each on sketch.