

MISSISSIPPI
BOARD OF WATER COMMISSIONERS
416 North State Street
Jackson, Mississippi 39201

CODED

WATER WELL DRILLERS LOG

NEWTON
J-53
7-31-71

July 31 1971 Wilkinson Drilling Serv Newton
date well completed firm name county well located

LANDOWNER: <u>Milton Rush</u>	description of formations encountered	from	to
<u>Lake, Miss</u> (mailing address)	<u>Red Clay</u>	<u>0</u>	<u>15</u>
WELL LOCATION:	<u>yellow clay + sand</u>	<u>15</u>	<u>90</u>
sec. <u>7</u> T. <u>6</u> N R. <u>10</u> E <u>3</u> miles <u>N</u> of <u>Lake</u> (distance) (direction) (nearest town)	<u>water sand</u>	<u>90</u>	<u>119</u>
WELL PURPOSE: <u>Home</u> (home, irrigation, municipal, industrial)			
WELL COMPLETION DATA:			
(1) diameter (inches) <u>2"</u>			
(2) total depth (feet) <u>119</u>			
(3) static water level (feet) <u>70</u> below above top of ground.			
(4) casing <u>galv.</u> <u>114</u> (material) (depth)			
_____ if telescope see back. (size)			
(5) screen <u>57</u> <u>5'</u> (length) (depth to top)			
_____ <u>St. Steel</u> (size) (material)			
(6) pump <u>1/2" Rod</u> <u>200 gal/hr.</u> (HP) (yield gpm)			
<u>E.</u> (type power)			
(7) electric log <u>no</u> (yes or no)			
_____ (organization running log)			
(8) how well bottom plugged <u>B.W.V.</u>			
DRILLERS REMARKS:			


CODED

AUG 5 - 1971

MISS. BD. OF
WATER COMM.

If well telescopes please sketch and show depths.

GROUND LEVEL

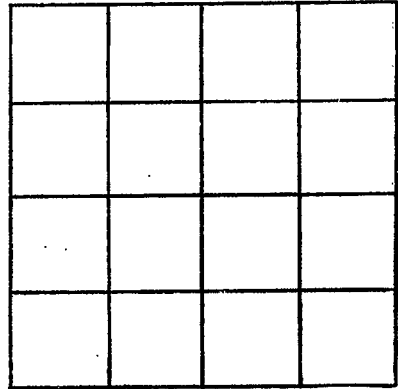

SECTION _____

Please indicate well location X.

ADDITIONAL INFORMATION

If more than one screen,
show locations of each on sketch.