

Newton
J55
3-7-72

MISSISSIPPI
 BOARD OF WATER COMMISSIONERS
 416 North State Street
 Jackson, Mississippi 39201

MAR 20 1972

WATER WELL DRILLERS LOG

3-7 1972 W. L. Shelch Newton
 date well completed firm name county well located

LANDOWNER Larry Deering
Lawrence
Miss
 (mailing address)

description of formations encountered	from	to
<u>Yellow clay</u>	<u>0</u>	<u>40</u>
<u>Sand</u>	<u>40</u>	<u>100</u>

WELL LOCATION:
 sec. 15 T. 6 N. R. 10 E.
4 miles NW of Lawrence
 (distance) (direction) (nearest town)

WELL PURPOSE: Home
 (home, irrigation, municipal, industrial)


- WELL COMPLETION DATA:
- (1) diameter (inches) 2"
 - (2) total depth (feet) 100
 - (3) static water level (feet) 22 below top of ground.
 - (4) casing Gal. Steel
 (material) (depth)
 (size) If telescope see back.
 - (5) screen 6'
 (length) (depth to top)
2 1/2" Steel
 (size) (material)
 - (6) pump 1 900
 (HP) (yield gpm)
 (type power)
 - (7) electric log ✓
 (yes or no)
 (organization running log)
 - (8) how well bottom plugged

60'
1 1/2"
3/100
10/15
1/2"
60'
2 1/2"

DRILLERS REMARKS:

If well telescopes please sketch and show depths.

GROUND LEVEL

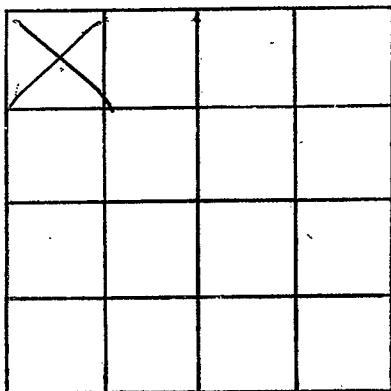

SECTION _____

Please indicate well location X.

ADDITIONAL INFORMATION

If more than one screen, show locations of each on sketch.