

Newton  
J56  
5-24-72

MISSISSIPPI  
 BOARD OF WATER COMMISSIONERS  
 416 North State Street  
 Jackson, Mississippi 39201

**CODED**

WATER WELL DRILLERS LOG

5-24 1972 U. L. Shelch Newton  
 date well completed firm name county well located

LANDOWNER: J. P. Mays  
Lawrence  
Miss 39336  
 (mailing address)

description of formations encountered	from	to
clay	0	18
Sand	18	64
Blue	64	80
Gray + Shale	80	100
Gray	100	160
Brack	160	220
B + S + G	220	250
Sand	250	330

WELL LOCATION:  
 sec. 14 T. 6 N. R. 10 E.  
4 miles N of Lawrence  
 (distance) (direction) (nearest town)

WELL PURPOSE: Home  
 (home, irrigation, municipal, industrial)

WELL COMPLETION DATA:

(1) diameter (inches) 4 + 2

(2) total depth (feet) 330

(3) static water level (feet) 195 below top of ground.

(4) casing 4" black  
 (material) (depth)  
 (size) if telescope see back.

(5) screen 5' 10"  
 (length) (depth to top)  
2 1/2" 5 steel  
 (size) (material)

(6) pump 1 450  
 (HP) (yield gpm)  
elec.  
 (type power)

(7) electric log NO  
 (yes or no)

(organization running log)

**CODED**

MAY 21 1972



MISS. BD. OF  
 WATER COMMISSIONERS

(8) how well bottom plugged

DRILLERS REMARKS:

If well telescopes please sketch and show depths.

GROUND LEVEL

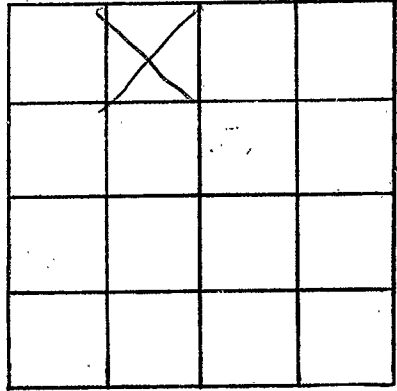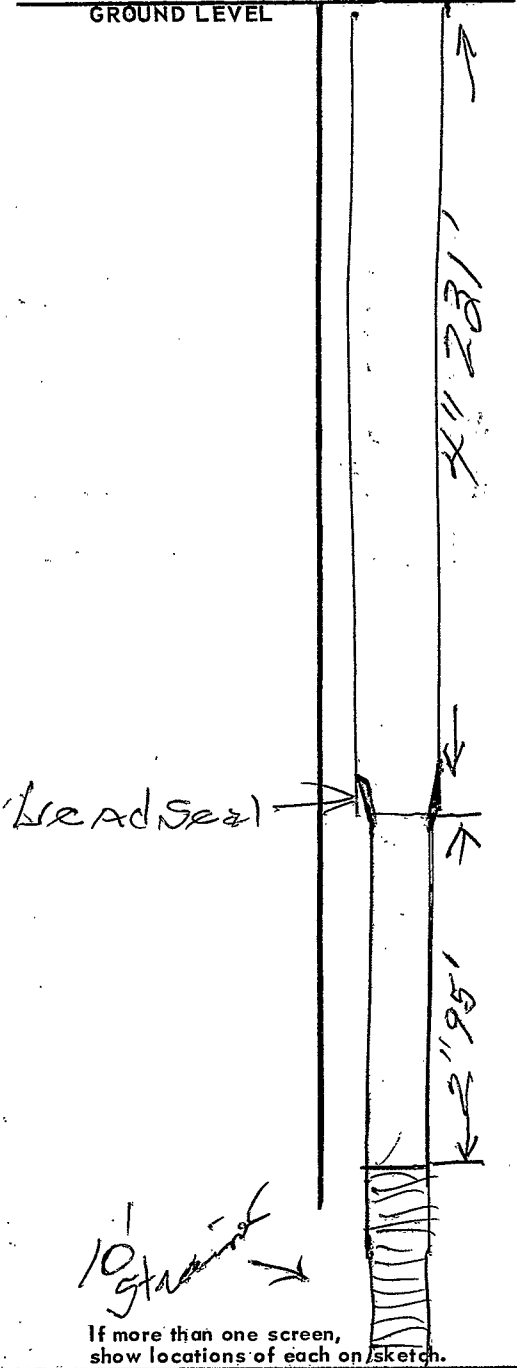

SECTION \_\_\_\_\_

Please indicate well location X.

ADDITIONAL INFORMATION

Lined area for additional information.

If more than one screen, show locations of each on sketch.