

Newton
J57
5-72

MISSISSIPPI
 BOARD OF WATER COMMISSIONERS
 416 North State Street
 Jackson, Mississippi 39201

CODED

WATER WELL DRILLERS LOG

date well completed May 19 72 firm name Wilkinson Drill Sew county well located Newton


LANDOWNER: <u>Leon Harrington</u>	description of formations encountered	from	to
<u>Lake, Miss</u> <u>Route</u> (mailing address)	<u>Yellow Clay</u> <u>Sand (fine)</u> <u>Water Sand</u>	<u>0</u> <u>20</u> <u>105</u>	<u>20</u> <u>105</u> <u>115</u>
WELL LOCATION:			
sec. <u>4</u> T. <u>6</u> N. R. <u>10</u> E. miles <u>7.5</u> N.E. of <u>Lake</u> (distance) (direction) (nearest town)			
WELL PURPOSE: <u>Home</u> (home, irrigation, municipal, industrial)			
WELL COMPLETION DATA:			
(1) diameter (inches) <u>2</u>			
(2) total depth (feet) <u>115</u>			
(3) static water level (feet) <u>40</u> below above top of ground.			
(4) casing <u>galv.</u> <u>115</u> (material) (depth) (size) if telescope see back.			
(5) screen <u>4</u> <u>115"</u> (length) (depth to top) <u>2"</u> <u>St. Steel</u> (size) (material)			
(6) pump <u>1</u> <u>Elec.</u> (HP) (yield gpm) (type power)			
(7) electric log <u>no</u> (yes or no) (organization running log)			
(8) how well bottom plugged <u>B.W.V.</u>			
DRILLERS REMARKS:			

CODED

JUN - 8 1972

If well telescopes please sketch and show depths.

GROUND LEVEL

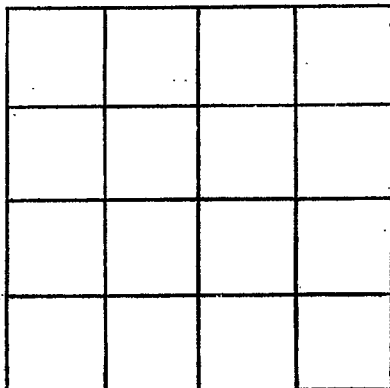

SECTION _____

Please indicate well location X.

ADDITIONAL INFORMATION

If more than one screen,
show locations of each on sketch.