

Newton
J 59
9-23-72

MISSISSIPPI
 BOARD OF WATER COMMISSIONERS
 416 North State Street
 Jackson, Mississippi 39201

CODED

WATER WELL DRILLERS LOG

9-23 1972 W. L. Welch Newton
 date well completed firm name county well located

LANDOWNER: H. Cotton
Lawrence
Miss
 (mailing address)

description of formations encountered	from	to
<u>Red clay +</u>		
<u>Sandy</u>	<u>0</u>	<u>55</u>
<u>Brown</u>	<u>55</u>	<u>80</u>
<u>Grey</u>	<u>80</u>	<u>100</u>
<u>Sand</u>	<u>100</u>	<u>155</u>

WELL LOCATION:
 sec 23 T 6 N R 19 E
2 miles N of Lawrence
 (distance) (direction) (nearest town)

WELL PURPOSE: Home
 (home, irrigation, municipal, industrial)

- WELL COMPLETION DATA:
- (1) diameter (inches) 3 1/2
 - (2) total depth (feet) 155
 - (3) static water level (feet) 35 below top of ground
 - (4) casing Steel (material) (depth)
 - (size) if telescope see back.
 - (5) screen 5' (length) (depth to top)
 - 2 1/2" (size) Steel (material)
 - (6) pump 1 (HP) 1000 (yield gpm)
 - (type power)
 - (7) electric log (yes or no)
 - (organization running log)
 - (8) how well bottom plugged

CODED


DRILLERS REMARKS:
Pumping water
air

SEP 27 1972

MISSISSIPPI
 BOARD OF WATER COMMISSIONERS

If well telescopes please sketch and show depths.

GROUND LEVEL

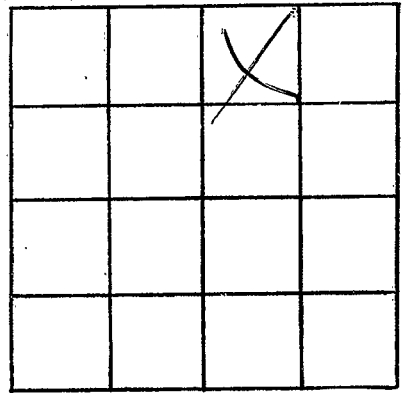

SECTION _____

Please indicate well location X.

ADDITIONAL INFORMATION

If more than one screen, show locations of each on sketch.