

Newton
J 61
2-73

MISSISSIPPI
 BOARD OF WATER COMMISSIONERS
 416 North State Street
 Jackson, Mississippi 39201

CODED

WATER WELL DRILLERS LOG

Feb 19 73 R.R. Wilberon Drill Sew. Newton
 date well completed firm name county well located

LANDOWNER: Homer Morgan
Lake, Miss
Route
 (mailing address)

description of formations encountered	from	to
<u>yellow clay</u>	<u>0</u>	<u>30</u>
<u>layers of rocks</u>	<u>40</u>	<u>70</u>
<u>yellow clay</u>	<u>70</u>	<u>80</u>
<u>stone sand</u>	<u>80</u>	<u>105</u>
<u>water bag sand</u>	<u>105</u>	<u>131</u>

WELL LOCATION:
 sec. 6 T. 6 N. R. 10 E.
4 miles N.E. of Lake
 (distance) (direction) (nearest town)

WELL PURPOSE: Home
 (home, irrigation, municipal, industrial)

WELL COMPLETION DATA:

- (1) diameter (inches) 2
- (2) total depth (feet) 131
- (3) static water level (feet) 50 below above top of ground.
- (4) casing Galv. 126'
 (material) (depth)
- If telescope see back.
 (size)
- (5) screen 5'
 (length) (depth to top)
- 2" Stee
 (size) (material)
- (6) pump 1 8
 (HP) (yield gpm)
- Elec.
 (type power)
- (7) electric log No
 (yes or no)
- (organization running log)
- (8) how well bottom plugged B.W. Valve


CODED

DRILLERS REMARKS:

MISS 0 1973

If well telescopes please sketch and show depths.

GROUND LEVEL

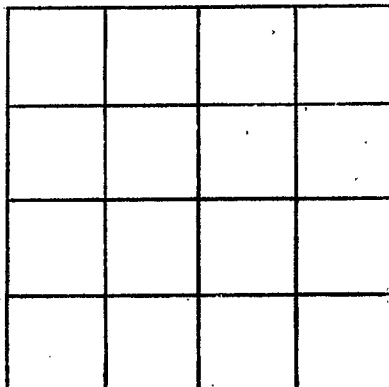

SECTION _____

Please indicate well location X.

ADDITIONAL INFORMATION

If more than one screen,
show locations of each on sketch.