

NEWTON  
J 62  
4-5-73

MISSISSIPPI  
 BOARD OF WATER COMMISSIONERS  
 416 North State Street  
 Jackson, Mississippi 39201

WATER WELL DRILLERS LOG

**CODED**

4-5 1973 U. L. Wheeler Merits  
 date well completed firm name county well located

LANDOWNER: S. Jones  
Lawrence  
Miss  
 (mailing address)

description of formations encountered	from	to
<u>Red clay</u>	<u>0</u>	<u>30</u>
<u>White clay</u>	<u>30</u>	<u>50</u>
<u>Sand</u>	<u>50</u>	<u>100</u>

WELL LOCATION:  
 sec. 21 T. 6 S. R. 100  
3 miles NW of Lawrence  
 (distance) (direction) (nearest town)

WELL PURPOSE: home  
 (home, irrigation, municipal, industrial)

**CODED**


- WELL COMPLETION DATA:
- diameter (inches) 2"
  - total depth (feet) 100
  - static water level (feet) 35 below above top of ground.
  - casing Gal Steel  
(material) (depth)  
\_\_\_\_ (size) If telescope see back.
  - screen 6'  
(length) (depth to top)  
20 S. Steel  
(size) (material)
  - pump \_\_\_\_\_ (HP) \_\_\_\_\_ (yield gpm)  
\_\_\_\_ (type power)
  - electric log \_\_\_\_\_ (yes or no)  
\_\_\_\_ (organization running log)
  - how well bottom plugged \_\_\_\_\_

DRILLERS REMARKS: This is a stand by well for later use.

1973 24 15100

If well telescopes please sketch and show depths.

GROUND LEVEL

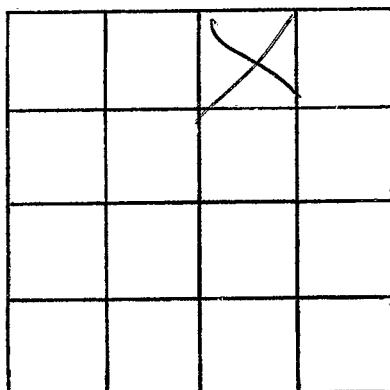

SECTION \_\_\_\_\_

Please indicate well location X.

ADDITIONAL INFORMATION

If more than one screen,  
show locations of each on sketch.