

NEWTON
 J63
 7-23-73

MISSISSIPPI
 BOARD OF WATER COMMISSIONERS
 416 North State Street
 Jackson, Mississippi 39201

CODED

WATER WELL DRILLERS LOG

6-18 1973 *T. J. L. Welch* Newton
 date well completed firm name county well located

LANDOWNER:

Pinckville Church
Lawrence Miss
 (mailing address)

description of formations encountered

from to

Red Clay	0	16
Sand	16	38
Gray	38	100
Gray Sandy	100	140
Sand	140	182

WELL LOCATION:

sec 21 T 6N R 10E
3 1/2 miles NW of Jarvis
 (distance) (direction) (nearest town)

WELL PURPOSE:

(home, irrigation, municipal, industrial)

Church

WELL COMPLETION DATA:

- (1) diameter (inches) 7"
- (2) total depth (feet) 182
- (3) static water level (feet) 48 below above top of ground.
- (4) casing 40 steel
(material) (depth)
- (size) If telescope see back.
- (5) screen 5'
(length) (depth to top)
- 3" Brass
(size) (material)
- (6) pump _____
(HP) (yield gpm)
- (type power) _____
- (7) electric log NO
(yes or no)
- (organization running log) _____
- (8) how well bottom plugged _____

CODED


DRILLERS REMARKS:

The Drillers
will finish well

III 10 1973

If well telescopes please sketch and show depths.

GROUND LEVEL

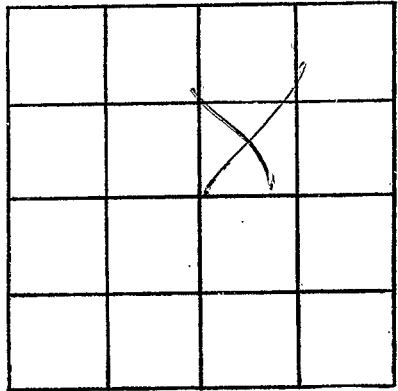

SECTION _____

Please indicate well location X.

ADDITIONAL INFORMATION

If more than one screen,
show locations of each on sketch.