

NEWTON

J 64

7-23-73

MISSISSIPPI BOARD OF WATER COMMISSIONERS
416 North State Street
Jackson, Mississippi 39201

CODED

WATER WELL DRILLERS LOG

6-11 1973 U. L. Shelch Newton
date well completed firm name county well located

LANDOWNER:

M. Parker
Lawrence Linn
(mailing address)

description of formations encountered

from to

Red clay 0 18
Sand 18 112

WELL LOCATION:

sec 14 T 6 N R 10 E
2 1/2 miles N of Lawrence
(distance) (direction) (nearest town)

WELL PURPOSE:

home (home, irrigation, municipal, industrial)

WELL COMPLETION DATA:

- (1) diameter (inches) 2 1/2
- (2) total depth (feet) 112
- (3) static water level (feet) 35 below top of ground.
- (4) casing gal steel (material) (depth) (size) if telescope see back.
- (5) screen 6 (length) (depth to top) 25.5 steel (size) (material)
- (6) pump (HP) (yield gpm) (type power)
- (7) electric log no (yes or no)
- (organization running log)
- (8) how well bottom plugged

CODED


JUL 10 1973

DRILLERS REMARKS:

He is going to install pump himself

If well telescopes please sketch and show depths.

GROUND LEVEL

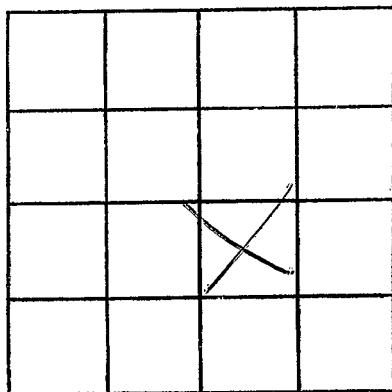

SECTION _____

Please indicate well location X.

ADDITIONAL INFORMATION

If more than one screen,
show locations of each on sketch.