

NEWTON
J 65
7-23-73

MISSISSIPPI
 BOARD OF WATER COMMISSIONERS
 416 North State Street
 Jackson, Mississippi 39201
WATER WELL DRILLERS LOG

CODED

7-10 1973 Wilkinson Drilling Newton
 date well completed firm name county well located

LANDOWNER: Mr. Louis S. Crosby
LAKE MISS
 (mailing address)

description of formations encountered	from	to
<u>Clay & sand</u>	<u>0</u>	<u>25</u>
<u>Brown clay</u>	<u>25</u>	<u>75</u>
<u>SAND</u>	<u>75</u>	<u>150</u>

WELL LOCATION:
 sec 7 T 6 N S R 10 E W
11 miles N.E. of LAKE
 (distance) (direction) (nearest town)

WELL PURPOSE: home
 (home, irrigation, municipal, industrial)

WELL COMPLETION DATA:

- (1) diameter (inches) 2
- (2) total depth (feet) 150
- (3) static water level (feet) 31 below above top of ground.
- (4) casing PUC 5440 145
 (material) (depth)
 if telescope see back.
 (size)
- (5) screen 5' 150
 (length) (depth to top)
2 Stainless Steel
 (size) (material)
- (6) pump 1 14
 (HP) (yield gpm)
51cc - Air
 (type power)
- (7) electric log NO
 (yes or no)

 (organization running log)
- (8) how well bottom plugged 2" Bck!


CODED

18 1973

DRILLERS REMARKS:

If well telescopes please sketch and show depths.

GROUND LEVEL

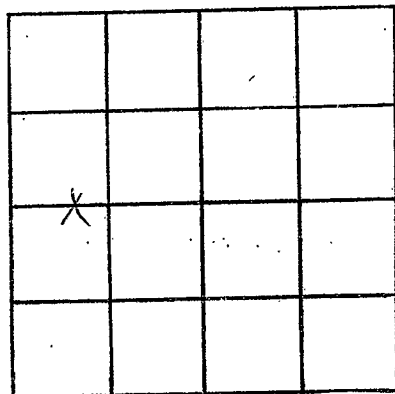

SECTION 9

Please indicate well location X.

ADDITIONAL INFORMATION

If more than one screen, show locations of each on sketch.