

**NEWTON**  
**J67**  
**6-16-74**

MISSISSIPPI  
 BOARD OF WATER COMMISSIONERS  
 416 North State Street  
 Jackson, Mississippi 39201 **CODED**

**WATER WELL DRILLERS LOG**

6-16 1974 H. L. Welch Newton  
 date well completed firm name county well located

LANDOWNER: J. O. Cotton  
Lawrence  
Miss  
 (mailing address)

WELL LOCATION:  
 sec. 20 T 6 N R 10 E  
 S  
4 miles NW of Amherst  
 (distance) (direction) (nearest town)

WELL PURPOSE: Drainage  
 (home, irrigation, municipal, industrial)

- WELL COMPLETION DATA:
- (1) diameter (inches) 2 1/4
  - (2) total depth (feet) 191
  - (3) static water level (feet) 45 below top of ground.
  - (4) casing PVC (material), (depth)  
 (size) if telescope see back.
  - (5) screen 10' (length), (depth to top)  
2" (size), PVC (material)
  - (6) pump (HP) (yield gpm)  
 (type power)
  - (7) electric log (yes or no)  
 (organization running log)
  - (8) how well bottom plugged

description of formations encountered	from	to
<u>Red clay</u>	<u>0</u>	<u>20</u>
<u>Gravelly brown</u>	<u>20</u>	<u>40</u>
<u>Gravelly blue</u>	<u>40</u>	<u>80</u>
<u>Grey sandy</u>	<u>80</u>	<u>140</u>
<u>Gravel</u>	<u>140</u>	<u>191</u>

**CODED**


**REC'D**  
**MISS. BD. OF WATER COMMISSIONERS**  
 JUL - 2 1974

DRILLERS REMARKS: Failed to complete shot  
then self-pumping with air

MISS. BD. OF WATER COMMISSIONERS

If well telescopes please sketch and show depths.

GROUND LEVEL

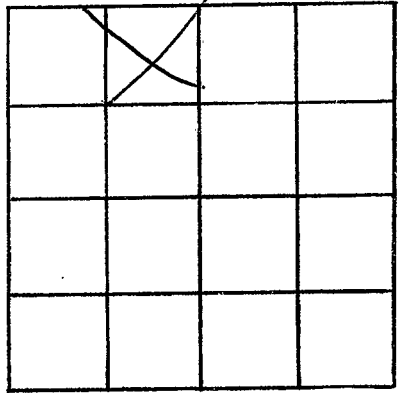

SECTION \_\_\_\_\_

Please indicate well location X.

ADDITIONAL INFORMATION

If more than one screen,  
show locations of each on sketch.