

NEWTON

J 70

8-22-74

MISSISSIPPI
 BOARD OF WATER COMMISSIONERS
 416 North State Street
 Jackson, Mississippi 39201

CODED

WATER WELL DRILLERS LOG

8-22

date well completed

1974 U. S. Welch

firm name

Newton

county well located

LANDOWNER: T. L. Justice

Some place in Georgia

(mailing address)

description of formations encountered

from

to

Grey

0 50

Brown

50 90

Blue Shale

90 125

Brown

125 140

Grey

140 165

WELL LOCATION:

sec. 2 T. 6 N. R. 10 E.

10 E

2 6 N

10 E

(distance) miles (direction) of (nearest town)

WELL PURPOSE: Farm (home, irrigation, municipal, industrial)

WELL COMPLETION DATA:

- (1) diameter (inches) 2"
- (2) total depth (feet) 470
- (3) static water level (feet) 130 below top of ground.

- (4) casing 2" steel (material) (depth) 400 (size) If telescope see back.

- (5) screen none Open (length) (depth to top) (size) (material)

- (6) pump 1/2 (HP) 300 (yield gpm) (type power)

- (7) electric log (yes or no)

(organization running log)

- (8) how well bottom plugged

Brown & Grey MIX 165 220

Brown Sandy 220 240


Sand 240 323

Dark Grey 323 396

Grey 396 426

Green Sand 426 460

Dark 460 470

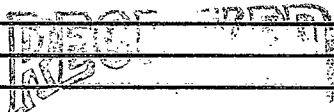

AUG 23 1974


DRILLERS REMARKS:

Open Hole

MISS. BD. OF WATER COMM

If well telescopes please sketch and show depths.

GROUND LEVEL

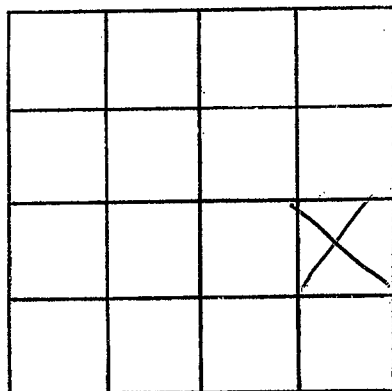

SECTION _____

Please indicate well location X.

ADDITIONAL INFORMATION

If more than one screen, show locations of each on sketch.