

Newton
J 73
8-5-75

MISSISSIPPI
 BOARD OF WATER COMMISSIONERS
 416 North State Street
 Jackson, Mississippi 39201

WATER WELL DRILLERS LOG

COPY

8-5 1975 H L Stewart Newton
 date well completed firm name county well located

LANDOWNER: W. Stewart
Newton
Miss
 (mailing address)

WELL LOCATION:
 sec. 1 T. 6 S. R. 10E 13 T
7 miles NW of Newton
 (distance) (direction) (nearest town)

WELL PURPOSE: Home
 (home, irrigation, municipal, industrial)

WELL COMPLETION DATA:

- (1) diameter (inches) 3"
- (2) total depth (feet) 450
- (3) static water level (feet) 137 below top of ground.
- (4) casing Gal Steel
 (material) (depth)
 _____ If telescope see back.
 (size)
- (5) screen none
 (length) (depth to top)
Open Hole
 (size) (material)
- (6) pump 1 1/2 300
 (HP) (yield gpm)
elec
 (type power)
- (7) electric log no
 (yes or no)
- _____ (organization running log)
- (8) how well bottom plugged _____

description of formations encountered	from	to
<u>Very Sandy</u>	<u>0</u>	<u>38</u>
<u>Blue</u>	<u>38</u>	<u>74</u>
<u>Blue & Shell</u>	<u>74</u>	<u>115</u>
<u>Braun</u>	<u>115</u>	<u>200</u>
<u>Sandy</u>	<u>200</u>	<u>240</u>
<u>Sand</u>	<u>240</u>	<u>325</u>
<u>Dark</u>	<u>325</u>	<u>350</u>
<u>Rock</u>	<u>350</u>	<u>450</u>
<u>Sand</u>	<u>450</u>	<u>450</u>
<u>Green</u>	<u>450</u>	<u>450</u>


AUG 27 1975

MISSISSIPPI BOARD OF WATER COMMISSIONERS

DRILLERS REMARKS:

If well telescopes please sketch and show depths.

GROUND LEVEL

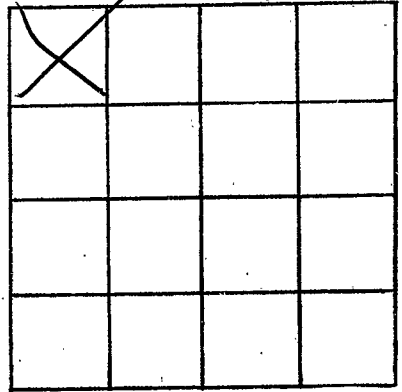

SECTION _____

Please indicate well location X.

ADDITIONAL INFORMATION

If more than one screen, show locations of each on sketch.