

NEWTON

J-77

11-10-80

11-10-80

MISSISSIPPI  
 BOARD OF WATER COMMISSIONERS  
 416 North State Street  
 Jackson, Mississippi 39201

CODED

WATER WELL DRILLERS LOG

McDonald + Hill

Newton

date well completed

firm name

county well located


LANDOWNER:	description of formations encountered	from	to
Marcus A. Hollingsworth	clay	0	12
Rt # 1 lake (mailing address)	shale	12	55
WELL LOCATION: sec 28 T 6 N R 10 E 2 1/2 miles S E of lake (distance) (direction) (nearest town)	sandy shale + shell	55	70
WELL PURPOSE: home (home, irrigation, municipal, industrial)	shale of sandy lignite	70	100
WELL COMPLETION DATA:	sand of shale	100	215
(1) diameter (inches) 4 X 2	med sand + of shale	215	245
(2) total depth (feet) 985'	shale	245	260
(3) static water level (feet) 195' below ground	sandy shale	260	320
(4) casing PVC 345' (material) (depth) 4" 630' 2" (size) if telescope see back.	sand & shell of shale	320	560
(5) screen 20' 965 to 985' (length) (depth to top) 2" 55' (size) (material)	sandy shale	560	610
(6) pump 1 1/2 20 gpm (HP) (yield gpm) K (type power)	shale	610	662
(7) electric log (yes or no)	Rock & shell	662	692
(8) how well bottom plugged	green sand & sandy shale	692	720
Organization running log NATURAL RESOURCES BUREAU OF LAND & WATER RESOURCES	shale & rock	720	860
	sandy shale	860	870
	med sand	870	880
	shale	880	950
	fine sand of shale	950	985
	med sand	985	

NOV 18 1980  
DRILLERS REMARKS:

RECEIVED

If well telescopes please sketch and show depths.

GROUND LEVEL

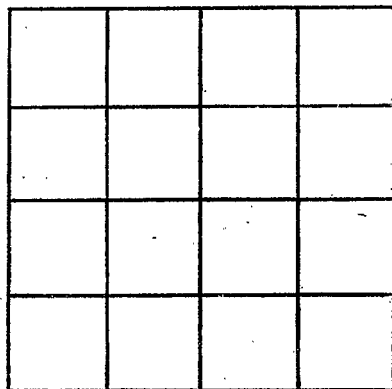

SECTION \_\_\_\_\_

Please indicate well location X.

ADDITIONAL INFORMATION

If more than one screen,  
show locations of each on sketch.