

NEWTON
 F 78
 5/86

MISSISSIPPI DEPARTMENT OF NATURAL RESOURCES
 Bureau of Land and Water Resources
 Southport Mall
 P.O. Box 10631
 Jackson, Mississippi 39209
 WATER WELL DRILLERS LOG CODED

~~SEA~~ MAX 1986 RIVER DRILLING SER. NEWTON
 date well completed firm name county well located

LANDOWNER:	description of formations encountered	from	to
SOUTH NEWTON	TOP SOIL	0	3
RURAL WATER ASSOC.	CLAY + SAND STREAKS	3	25
LAURENCE WELL NO. 2	CLAY	25	120
(mailing address)	SAND	120	198
WELL LOCATION: SEA SW 1/4 NW 1/4 N	W/4 CLAY + ROCKS	198	340
sec. 25 T. 6N S. R. 10E W	SAND + CLAY STREAKS	340	400
	SANDY CLAY	400	414
	SAND	414	492
	CLAY	492	503

WELL PURPOSE:
 (home, irrigation, municipal, industrial)

WELL COMPLETION DATA:

- (1) diameter (inches) 10 3/4
- (2) total depth (feet) 492 ft
- (3) static water level (feet) 188 below above top of ground.
- (4) casing steel 430 ft
 (material) (depth)
10 3/4 if telescope see back.
 (size)
- (5) screen 50 492
 (length) (depth to top)
6 30455 (.016")
 (size) (material)
- (6) pump 15 150
 (HP) (yield gpm)
ELECT
 (type power)
- (7) electric log Yes
 (yes or no)
MOS
 (organization running log)
- (8) how well bottom plugged BACK
WASH VALVE

CODED


MISSISSIPPI DEPARTMENT OF NATURAL RESOURCES
 BUREAU OF LAND & WATER RESOURCES
 MAY 8 1986

DRILLERS REMARKS:

Department of Natural Resources
 Bureau of Land & Water Resources
 Jackson, Mississippi 39209

If well telescopes please sketch and show depths.

GROUND LEVEL

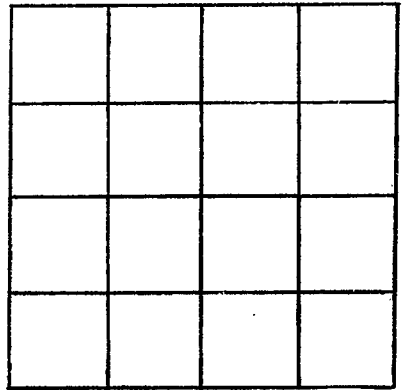

SECTION _____

Please indicate well location X.

ADDITIONAL INFORMATION

If more than one screen,
show locations of each on sketch.